


This plan document set is the sole property of Lloyd Consulting Group, LLC. No alterations to these plans, other than adding "as-built" information, are allowed by anyone other than authorized Lloyd Consulting Group, LLC employees.

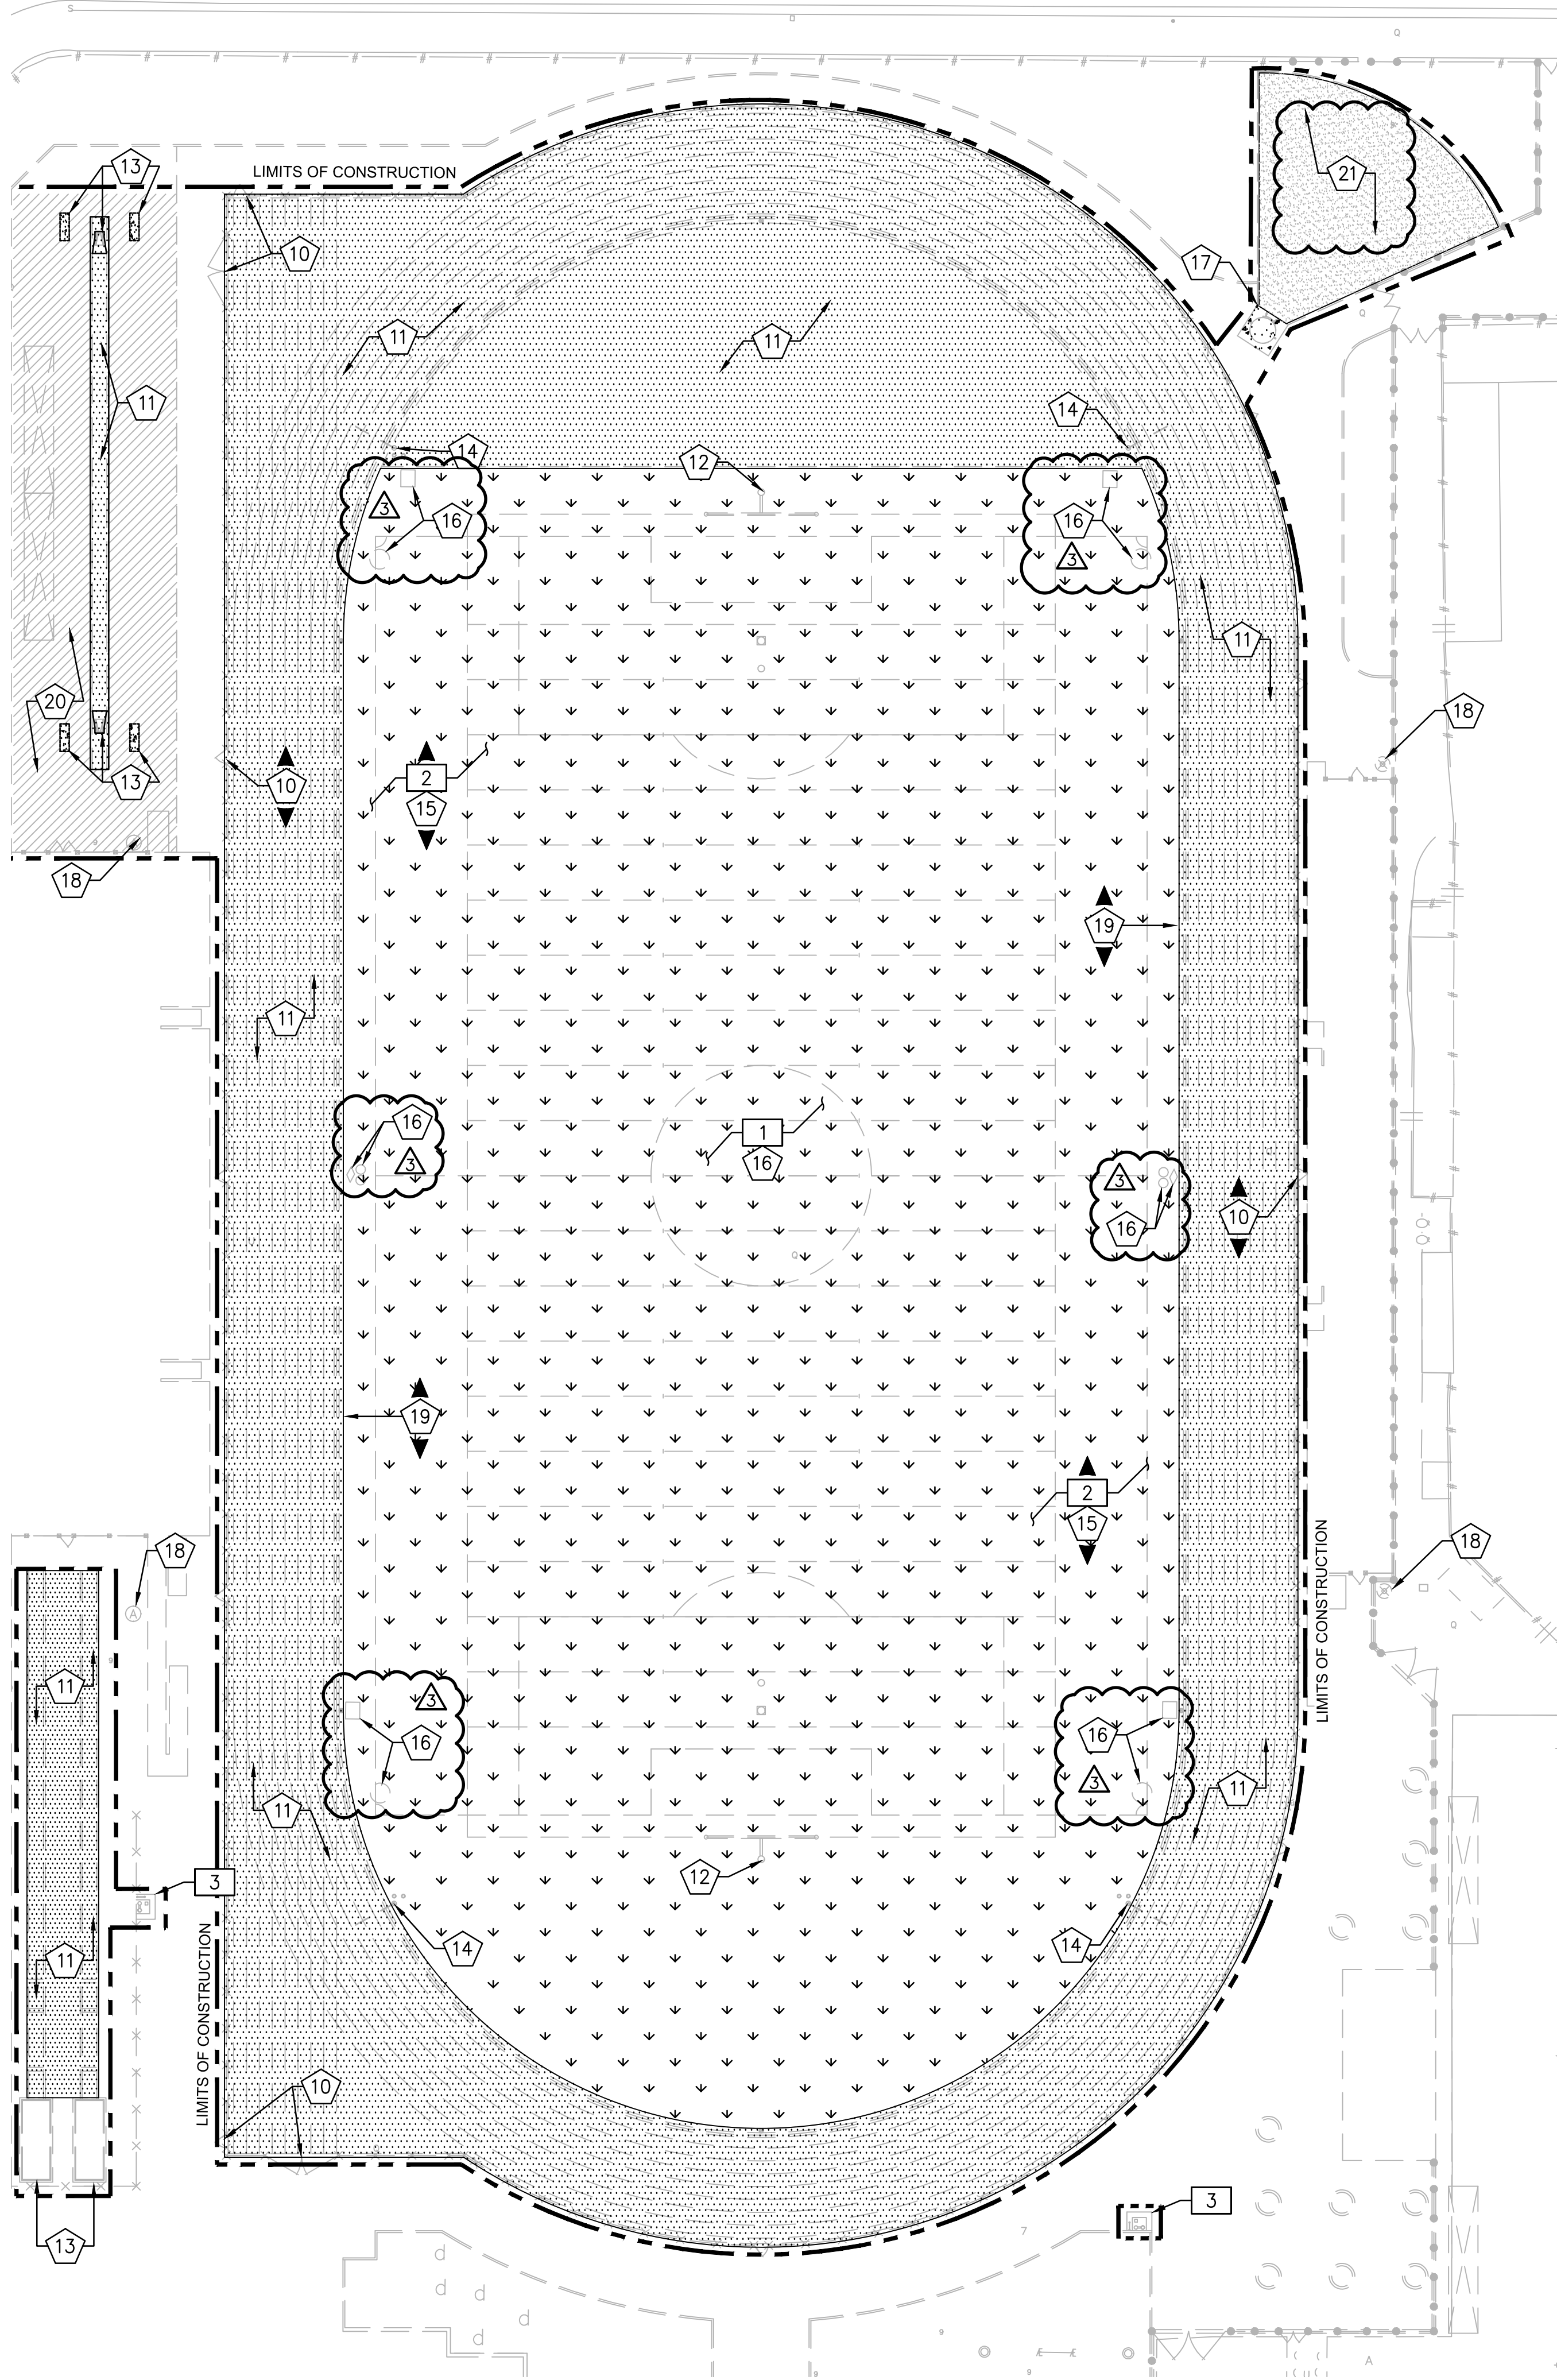

PROTECT IN PLACE NOTES

- 10 PROTECT IN PLACE EXISTING CONCRETE CURB, PERIMETER FENCE, AND GATES.
- 11 PROTECT IN PLACE EXISTING TRACK SURFACE AND ASPHALT BASE. CONTRACTOR TO CLEAN SURFACE OFF ALL DEBRIS. THE CONTRACTOR MUST THOROUGHLY INSPECT ENTIRE SURFACE AND REPAIR HOLES, CHIPS, CRACKS, BUMPS AND DIPS. REPAIR METHODS ARE TO BE SUBMITTED AND APPROVED BY ENGINEER PRIOR TO IMPLEMENTATION. CONTRACTOR MUST NOTIFY ENGINEER OF ANY DEFECTS WHICH MAY AFFECT THE LONG TERM STABILITY AND DURABILITY OF PAVEMENT AND TRACK SURFACING.
- 12 PROTECT IN PLACE EXISTING FOOTBALL GOAL POSTS.
- 13 PROTECT IN PLACE EXISTING POLE VAULT PIT, CONCRETE PADS AND LONG/TRIPLE JUMP PIT.
- 14 PROTECT IN PLACE EXISTING LANE GATES.
- 15 PROTECT IN PLACE EXISTING IRRIGATION AND/OR COMMUNICATION BOXES.
- 16 PROTECT IN PLACE EXISTING IRRIGATION, DRAINAGE PIPES AND DRAIN INLETS. CONTRACTOR MUST VERIFY EXISTING IRRIGATION AND/OR DRAINAGE LOCATIONS AND MAINTAIN FLOW AND AUTOMATED CONTROL SERVICE TO ANY ADJACENT LANDSCAPE OR DRAINAGE AREAS DURING AND AFTER CONSTRUCTION.
- 17 PROTECT IN PLACE EXISTING CONCRETE SHOT PUT THROWING PAD.
- 18 PROTECT IN PLACE EXISTING FIELD LIGHTING.
- 19 PROTECT IN PLACE EXISTING SLOT DRAIN. CLEAN AND FLUSH ALL DRAINS PER SPECIFICATIONS.
- 20 PROTECT IN PLACE EXISTING SYNTHETIC SURFACING. CLEAN AND PREPARE AREA FOR SPRAY COAT FINISH.
- 21 PROTECT IN PLACE EXISTING SHOT PUT AREA. REMOVE ALL WEEDS, ORGANIC MATERIAL AND DEBRIS FROM EXISTING SHOT PUT AREA.

DEMOLITION NOTES


- 1 REMOVE AND DISPOSE OF EXISTING SYNTHETIC TURF AND INFILL. DISPOSE OF TURF AND INFILL PER LOCAL CODES AND REQUIREMENTS.
- 2 REMOVE AND DISPOSE OF EXISTING SYNTHETIC TURF FROM ALL IRRIGATION AND COMMUNICATION BOXES. ACTUAL BOX LOCATIONS NOT SHOWN. CONTRACTOR MUST LOCATE ALL BOXES IN FIELD.
- 3 REMOVE AND REPLACE EXISTING DRINKING FOUNTAINS.

LEGEND

- EXISTING TRACK SURFACE TO BE PROTECTED
- EXISTING SYNTHETIC TURF PLAYING FIELD TO BE REMOVED
- EXISTING SPRAY MAT SURFACING TO BE PROTECTED
- EXISTING CONCRETE SURFACE TO BE PROTECTED
- EXISTING DECOMPOSED GRANITE
- LIMITS OF CONSTRUCTION
- KEYNOTE CALLOUT SYMBOL

GENERAL NOTES

1. CONTRACTOR MUST REMOVE AND DISPOSE OF ALL WEEDS, LOOSE MATERIALS, AND THOROUGHLY CLEAN THE TRACK/RUNWAY, DG AREAS TO RECEIVE THE NEW SURFACE.
2. AT THE CONCLUSION OF THE REPAIRS AND PREPARATION NO EXPOSED CONCRETE SURFACES SHALL BE VISIBLE ALONG THE PERIMETER AND OR EDGES OF ANY AREAS INTENDED FOR A SYNTHETIC TRACK AND FIELD RUNNING OR JUMPING SURFACE.
3. EXISTING STORM DRAIN FACILITIES WITHIN THE LIMITS OF CONSTRUCTION MUST BE PROTECTED FROM CONSTRUCTION DEBRIS INTRUSION AND MUST BE FLUSHED OUT AND CLEANED BY THE CONTRACTOR.
4. THE CONTRACTOR SHALL PROVIDE AND INSTALL EROSION CONTROL ITEMS SUCH AS SILT FENCING, HAY BALES, STABILIZED CONSTRUCTION ENTRANCES, AND INLET SEDIMENT TRAPS AS REQUIRED BY LOCAL CODE. THE CONTRACTOR IS RESPONSIBLE TO PROVIDE ANY EROSION CONTROL PLANS REQUIRED BY GOVERNMENT AGENCIES, AND OBTAIN ANY REQUIRED PERMITS.
5. CONTRACTOR IS RESPONSIBLE FOR MAINTAINING IRRIGATION SERVICE TO EXISTING LANDSCAPE MATERIAL TO REMAIN AND TO ADJACENT FIELDS BOTH DURING AND AFTER CONSTRUCTION.
6. THE CONTRACTOR MUST CONTACT LOCAL UTILITY LOCATION SERVICES PRIOR TO CONSTRUCTION.
7. THE CONTRACTOR MUST PROTECT IN PLACE ALL EXISTING UTILITIES. THE CONTRACTOR IS RESPONSIBLE FOR REPAIR OR REPLACEMENT OF UTILITIES DAMAGED DURING CONSTRUCTION.
8. THE CONTRACTOR IS RESPONSIBLE FOR RENOVATING ALL INFIELD BOXES PER PLAN NOTES AND DETAILS.

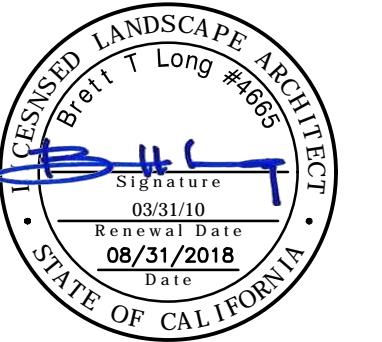

REV.		
1	ADDENDA 1	8/31/2018
2	ADDENDA 2	8/31/2018
3	ADDENDA 3	9/14/2018

OAK GROVE HIGH SCHOOL
TRACK & FIELD RESURFACING
285 Blossom Hill Road
San Jose, CA

SCALE:	1"=30'
DESIGNED:	BTL
DATE:	8/31/2018
DRAWN:	ZTP
PROJ.	18-120
APPROVED:	


DEMOLITION PLAN

DWG. NO.

TF-02

0 30 60 Feet
SCALE: 1" = 30'

This plan document set is the sole property of Lloyd Consulting Group, LLC. No alterations to these plans, other than adding "as-built" information, are allowed by anyone other than authorized Lloyd Consulting Group, LLC employees.

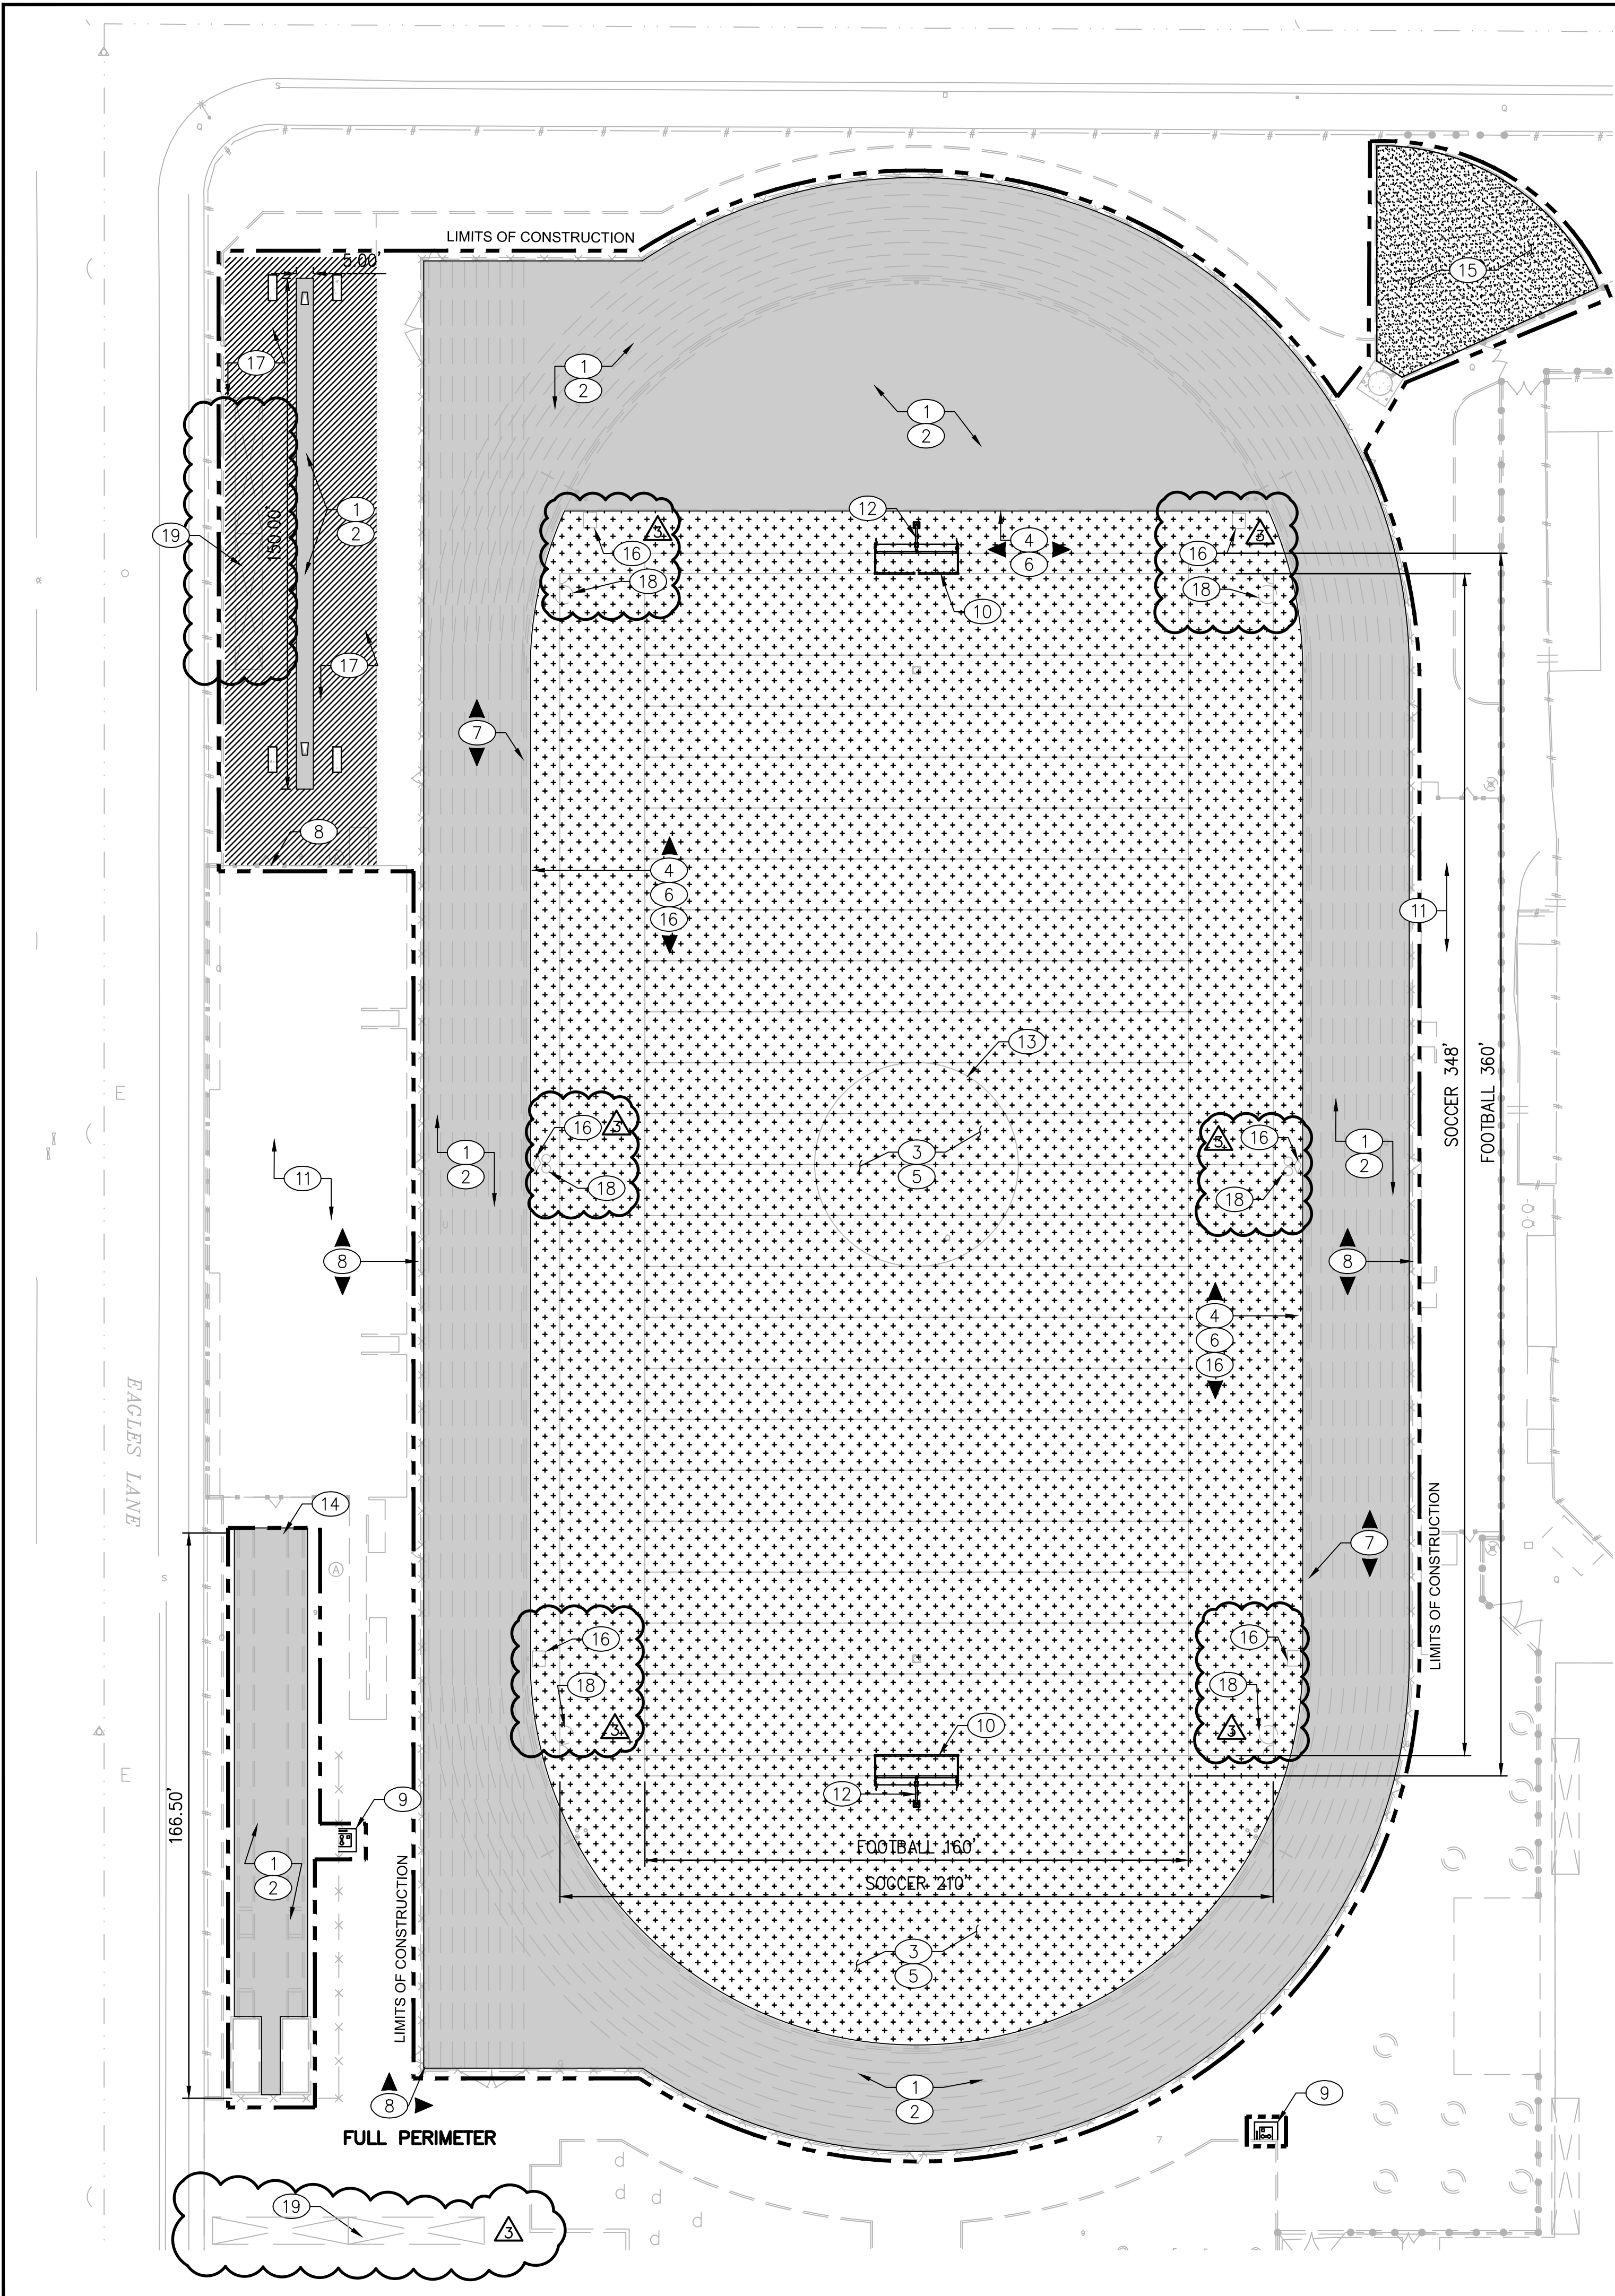

SURFACING NOTES:

1. INSTALL SYNTHETIC TRACK OVERLAY ON EXISTING RUNNING TRACK, D-ZONES, LONG/TRIPLE JUMP RUNWAYS & LANDING PIT COVERS PER DETAIL 02 ON SHEET TF-05.
2. STRIPE TRACK AND RUNWAYS PER NFHS REQUIREMENTS AND PER SPECIFICATIONS. SEE DETAIL 04 ON SHEET TF-05.
3. PRIOR TO SHOCK PAD/DRAIN LAYER INSTALLATION THE CONTRACTOR MUST CORRECT ANY RIDGES OR DEPRESSIONS IN PLAYING FIELD BASE THAT DO NOT MEET GRADING TOLERANCES PER THE SPECIFICATIONS.
4. ADJUST PLAYING FIELD BASE ELEVATIONS AT FIELD PERIMETER AND ADJUST NAILER BOARD ELEVATIONS TO MAINTAIN SMOOTH/FLUSH TRANSITION BETWEEN TURF AND TRACK SURFACES WITH NO GRADING GAP OR LIP. CONTRACTOR MUST REPLACE DAMAGED NAILER BOARDS. SEE DETAIL 06 ON SHEET TF-05.
5. INSTALL SYNTHETIC TURF SYSTEM WITH SHOCK PAD, DRAIN LAYER AND GEOTEXTILE FABRIC PER DETAIL 01 ON SHEET TF-05.
6. ATTACH SYNTHETIC TURF TO NAILER BOARD PER DETAIL 06 ON SHEET TF-05.
7. ALL SLOT DRAIN INLET OPENINGS TO REMAIN OPEN AND FREE OF SURFACING.
8. REPAIR EXISTING FENCE RAILS AS NEEDED. CLEAN, PRIME AND PAINT POSTS, RAILS & GATES. INSTALL NEW VINYL CLAD FABRIC ON FENCE AND GATES. REPAIR GATES & HARDWARE AS NEEDED. (COLOR BLACK)
9. INSTALL ELKAY HIGH/LOW ACCESSIBLE DRINKING FOUNTAIN WITH BOTTLE FILLER AT EXISTING DRINKING FOUNTAIN LOCATIONS PER DETAIL 01 ON SHEET TF-06.
10. INSTALL SOCCER GOALS WITH ANCHOR WEIGHTS PER SPECIFICATIONS.
11. CONTRACTOR TO PRESSURE WASH AND CLEAN ALL BLEACHERS AT THE END OF CONSTRUCTION.
12. CLEAN AND POWDER COAT GOAL POSTS NEON YELLOW AND REPLACE WIND FLAGS AT TOP OF POSTS PER SPECIFICATIONS.
13. REFER TO SHEET TF-04 FOR FOOTBALL AND SOCCER FIELD STRIPING LAYOUT.
14. CLEAN ALL SAND FROM PAVED AREAS AND REFRESH SAND PITS TO BE LEVEL WITH CURBS.
15. APPLY 1/2" OF MATCHING DECOMPOSED GRANITE AND STABILIZER AND RE-COMPACT TO FINISHED GRADE, PER DETAIL 02 ON SHEET TF-06.
16. ADJUST EXISTING COMMUNICATION/ELECTRIC AND IRRIGATION BOXES TO SIT FLUSH WITH NEW SYNTHETIC SURFACING, PER DETAIL 07 AND 08 ON SHEET TF-05.
17. CLEAN AND PREPARE AREA TO RECEIVE OVERLAY SPRAY COAT. INSTALL SPRAY COAT FINISH (COLOR BLACK).
18. ADJUST STORM DRAIN AND CLEANOUT ELEVATION TO UNDERSIDE OF SYNTHETIC SURFACING PER DETAIL 08 ON SHEET TF-05.
19. CLEAN, PRIME, AND PAINT EXISTING STORAGE CONTAINERS, INCLUDING SECURITY BARS. CONTRACTOR TO PUSH CONTAINERS TIGHT WHERE NECESSARY AND PAINT ALL EXPOSED SIDES INCLUDING ROOFS.

SURFACING LEGEND:

- SYNTHETIC TURF PLAYING FIELD
- RUBBERIZED SURFACE OVER EXISTING TRACK
- EXISTING CONCRETE SURFACE
- SYNTHETIC SPRAY COAT
- DECOMPOSED GRANITE MATERIAL
- LIMITS OF CONSTRUCTION
- KEYNOTE CALLOUT SYMBOL

GENERAL NOTES:

1. ALL COMPETITION REQUIRED STRIPES AND MARKINGS MUST BE INLAID AND MUST MEET THE LATEST REQUIREMENTS OF NFHS FOOTBALL AND SOCCER RULES. FOOTBALL MARKINGS TO BE WHITE AND SOCCER MARKINGS TO BE YELLOW.
2. GENERAL CONTRACTOR IS RESPONSIBLE FOR PREPARATION OF THE BASE IN THE TURF AREAS AND FOR COORDINATION WITH THE TURF INSTALLER'S WORK. TURF INSTALLER MUST SUBMIT COMPLETE SHOP DRAWINGS AND COLOR SAMPLES FOR REVIEW AND APPROVAL PRIOR TO INSTALLATION OF SYNTHETIC TURF. SUBMITTALS FOR SHOP DRAWINGS AND COLOR SAMPLES MUST BE IN ACCORDANCE WITH THE SPECIFICATIONS.
3. THE OWNER MUST REVIEW AND APPROVE THE FONTS USED FOR YARD LINE NUMBERING, ENDZONE LETTERING AND TRACK MARKINGS PRIOR TO INSTALLATION OF THE SYNTHETIC TURF OR STRIPING OF THE TRACK.
4. ALL SYNTHETIC SURFACE TRACK MARKINGS MUST BE CALIBRATED, CERTIFIED, AND CONFORM TO THE LATEST REQUIREMENTS OF NFHS.
5. THE EXISTING DRAINAGE SYSTEM MUST BE MAINTAINED OR REPAIRED WHEREVER DAMAGE IS DISCOVERED. ALL DRAINAGE SYSTEMS WITHIN LIMIT OF WORK SHALL BE CLEANED AND FLUSHED BY CONTRACTOR PER SPECIFICATIONS.
6. SUPPLY 2 BAGGED YARDS OF JUMP PIT SAND FOR ATTIC STOCK.



REV.		
1	ADDENDA 1	8/31/2018
2	ADDENDA 2	8/31/2018
3	ADDENDA 3	9/14/2018


OAK GROVE HIGH SCHOOL
TRACK & FIELD RESURFACING
285 Blossom Hill Road
San Jose, CA

SCALE:	1"=30'
DESIGNED:	BTL
DATE:	8/31/2018
DRAWN:	ZTP
PROJ.	18-120
APPROVED:	


SURFACING PLAN

DWG. NO.


TF-03

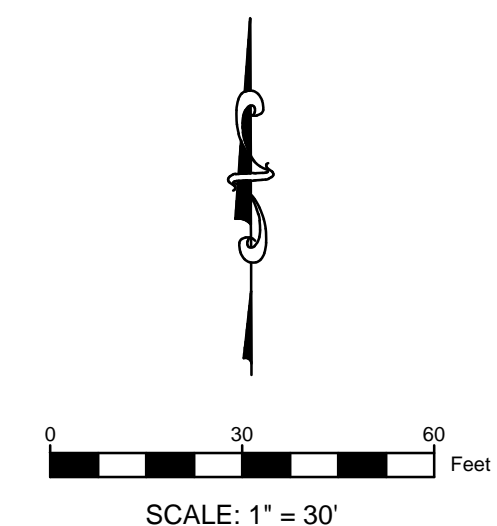


This plan document set is the sole property of Lloyd Consulting Group, LLC. No alterations to these plans, other than adding "as-built" information, are allowed by anyone other than authorized Lloyd Consulting Group, LLC employees.

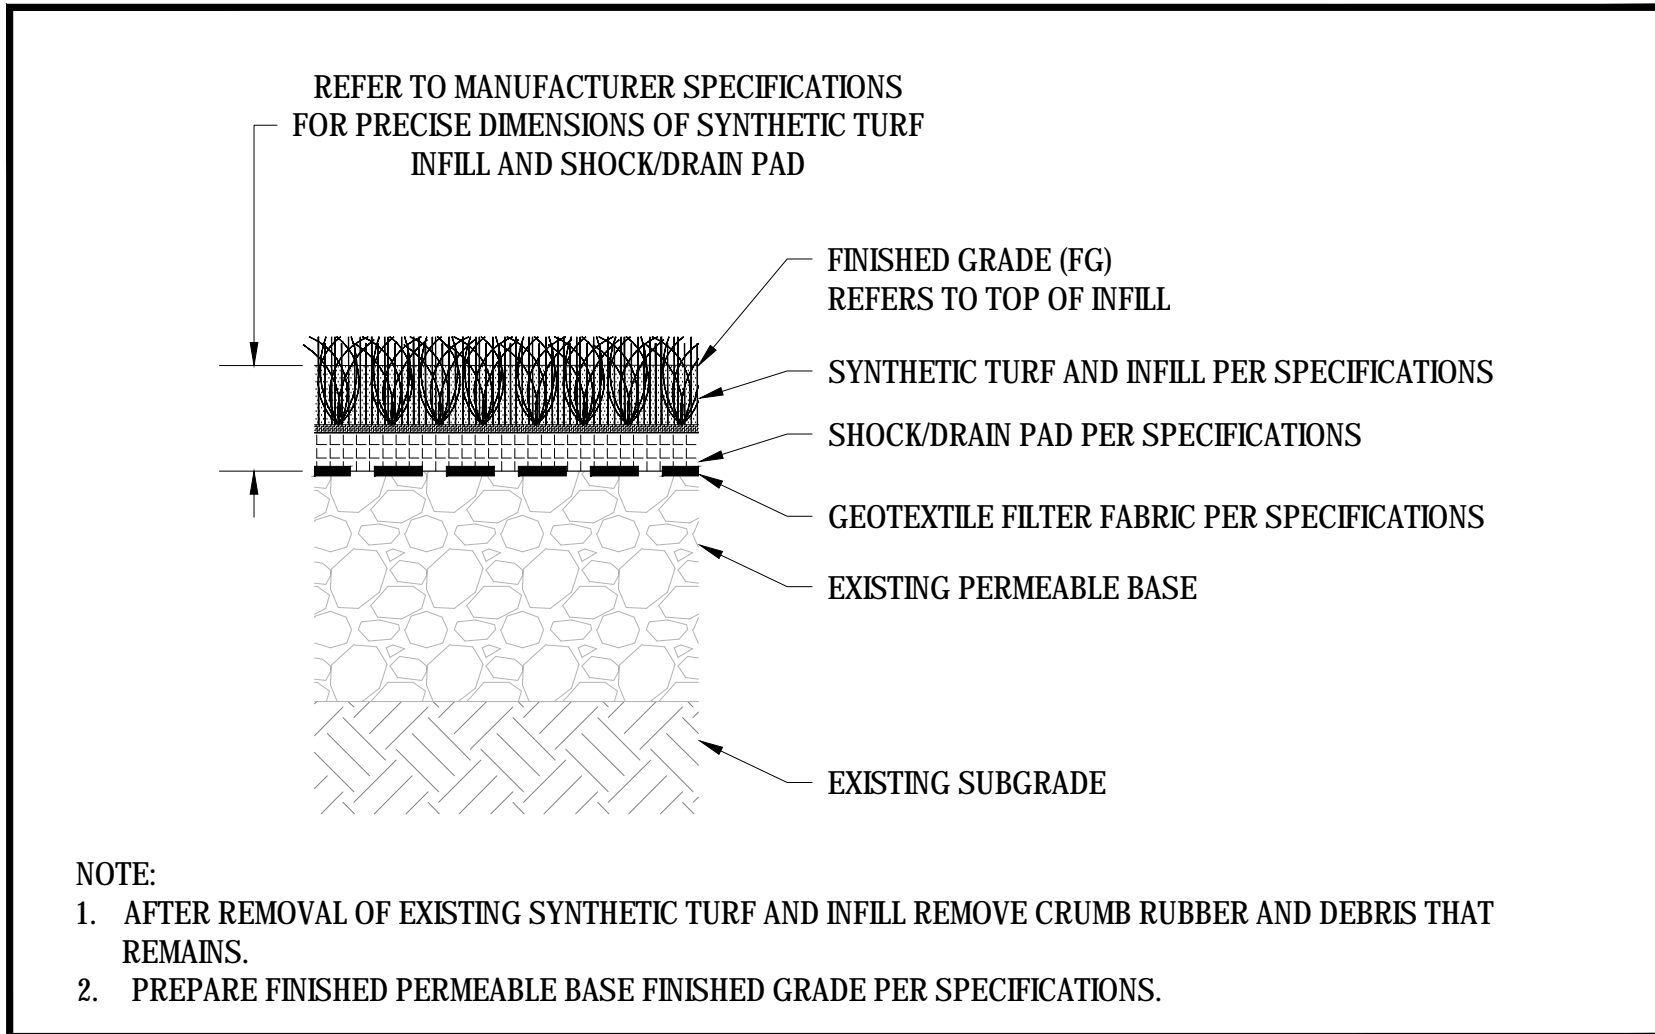


01 SYNTHETIC TURF SURFACING
SCALE: NTS

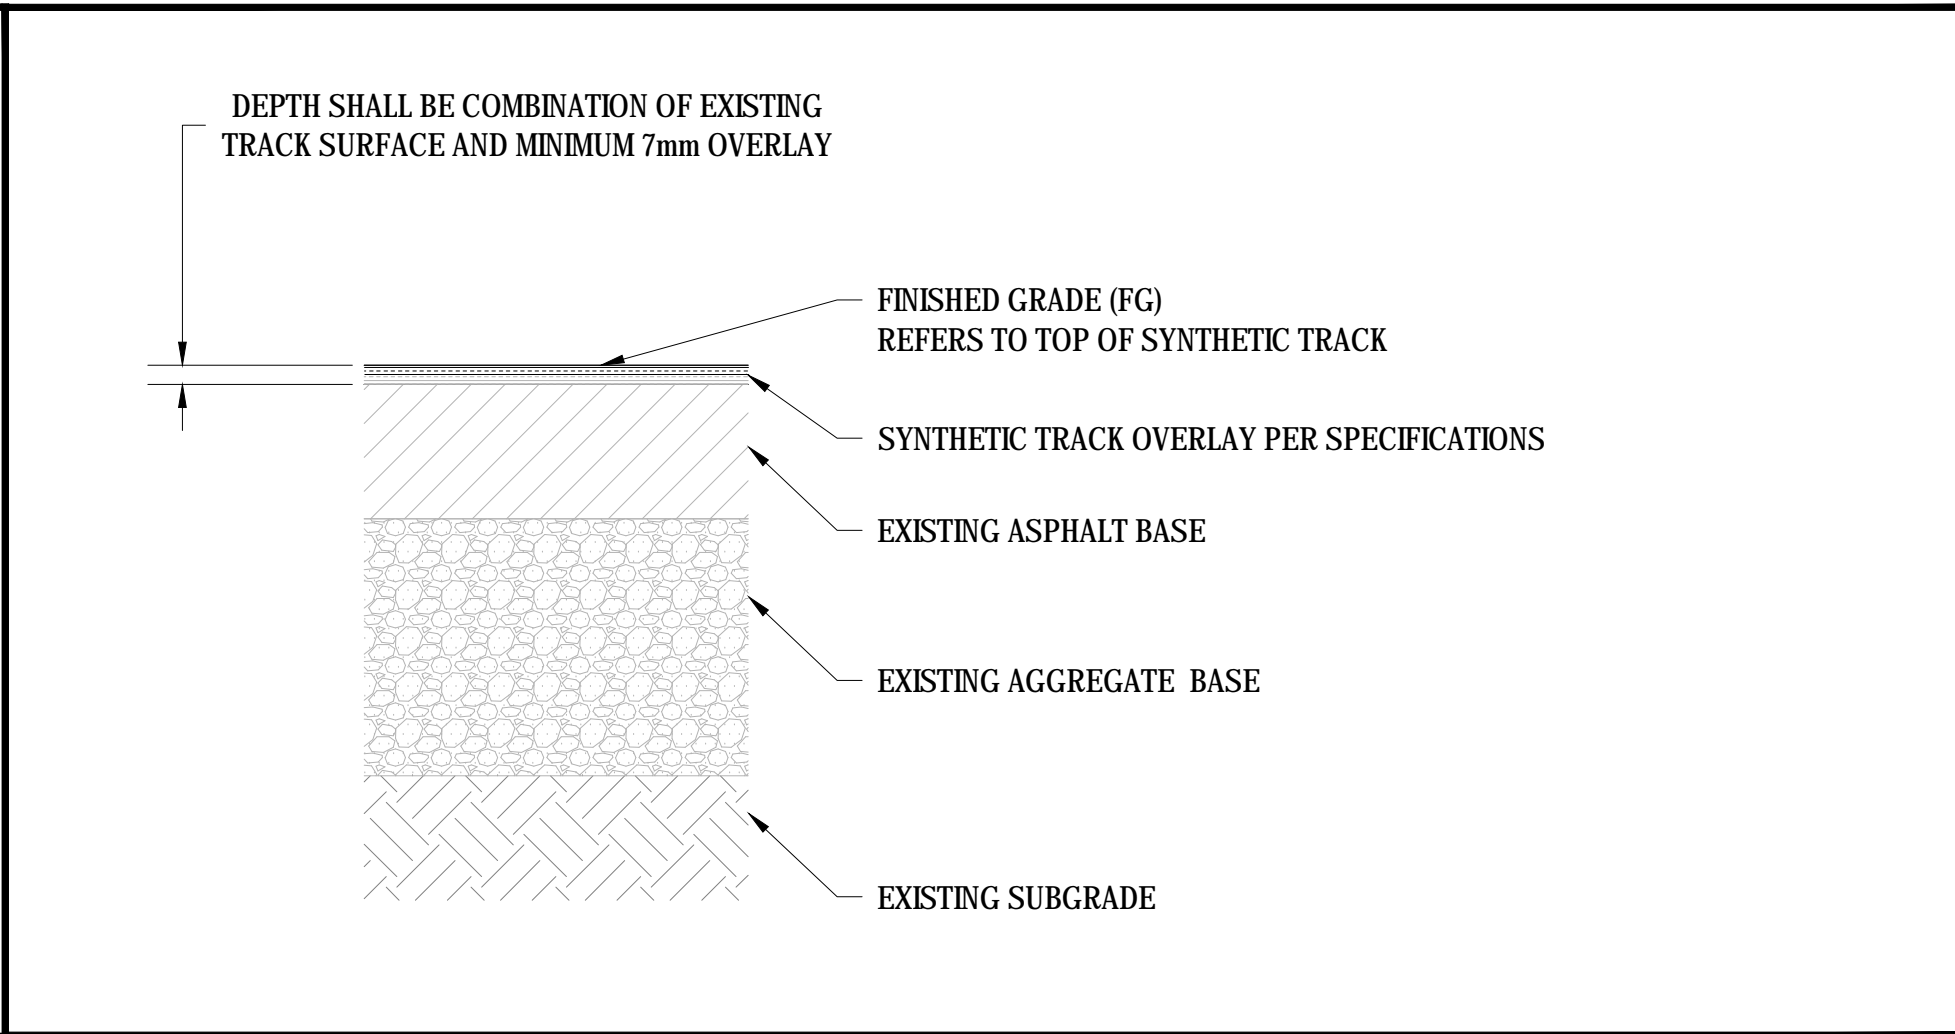


02 SYNTHETIC TRACK SURFACING
SCALE: NTS

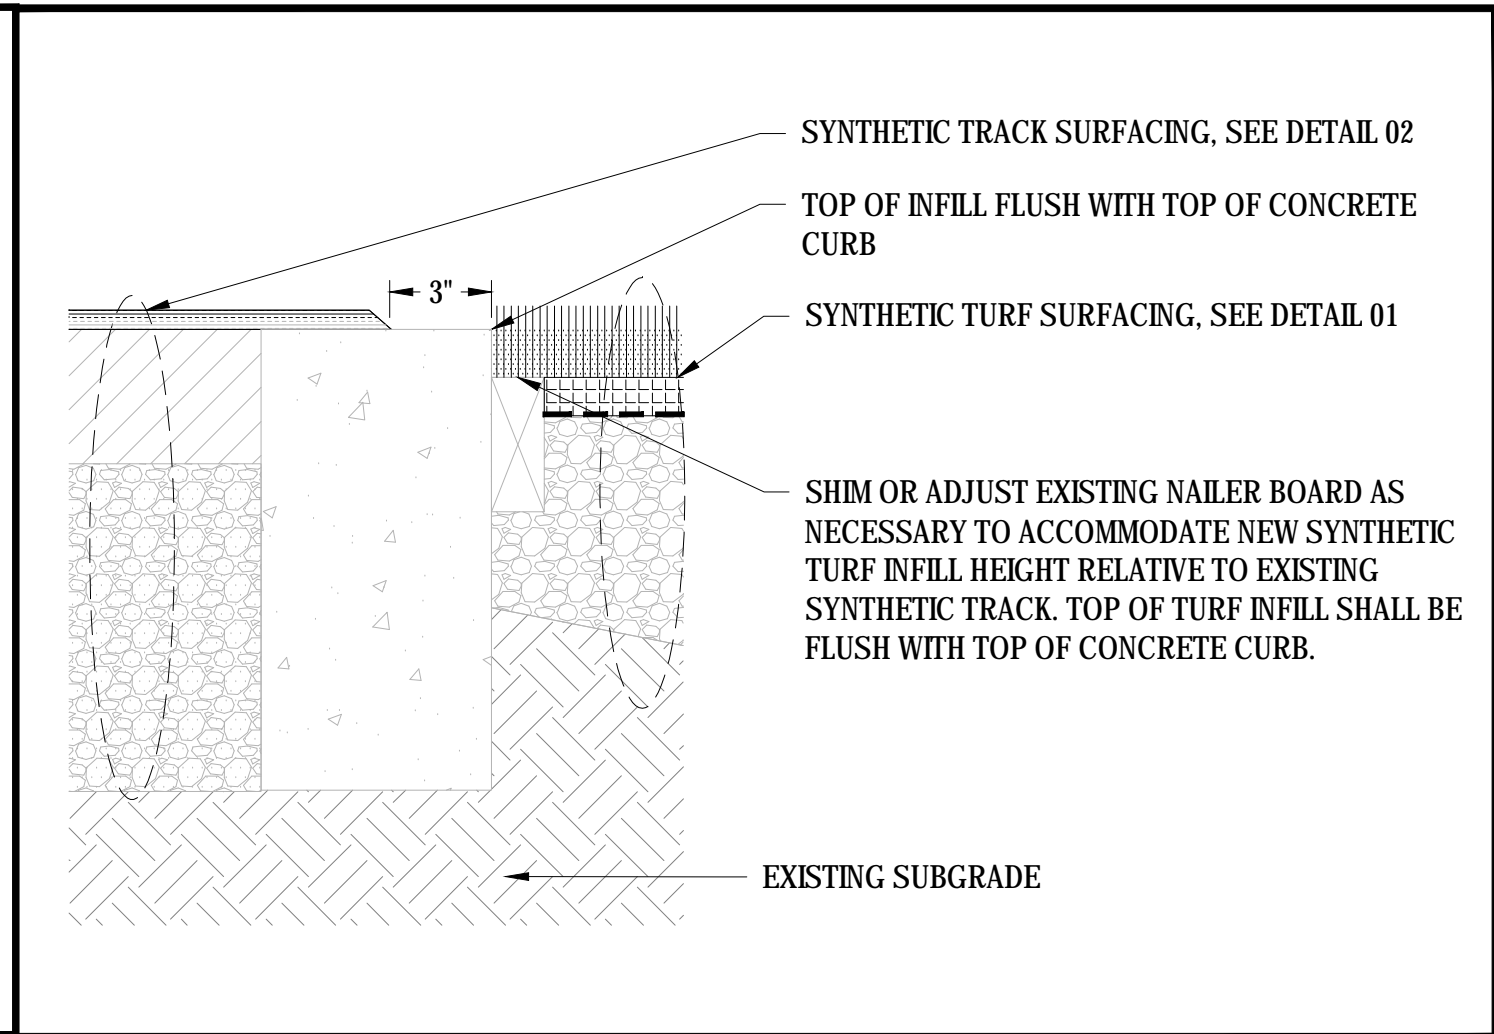


03 SYNTHETIC SURFACING & NAILER AT CURB EDGE
SCALE: NTS

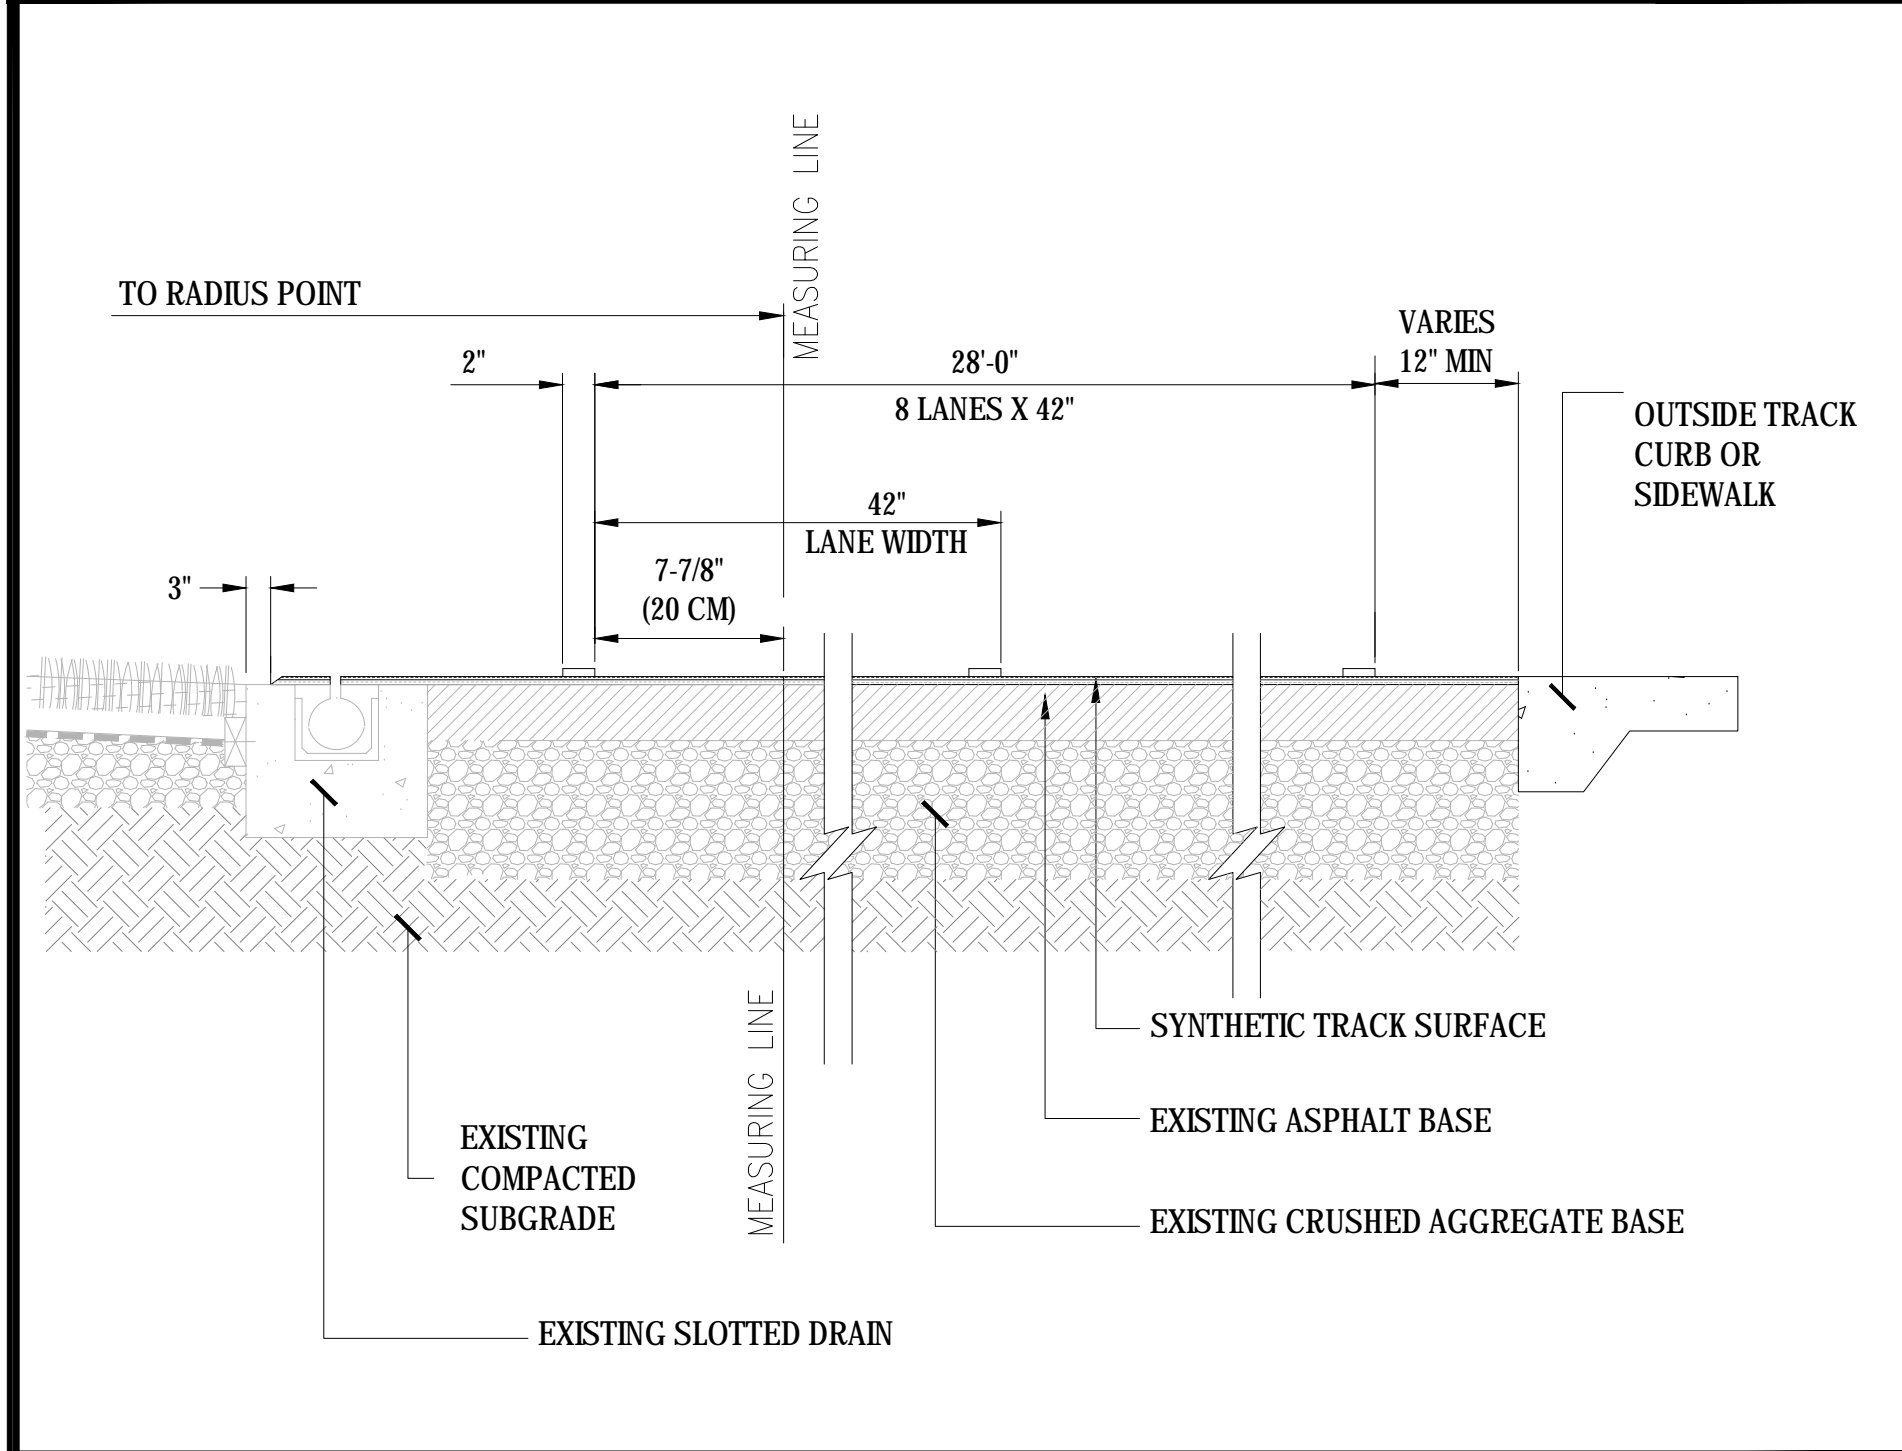


04 RUNNING TRACK LANE DIMENSIONS
SCALE: NTS

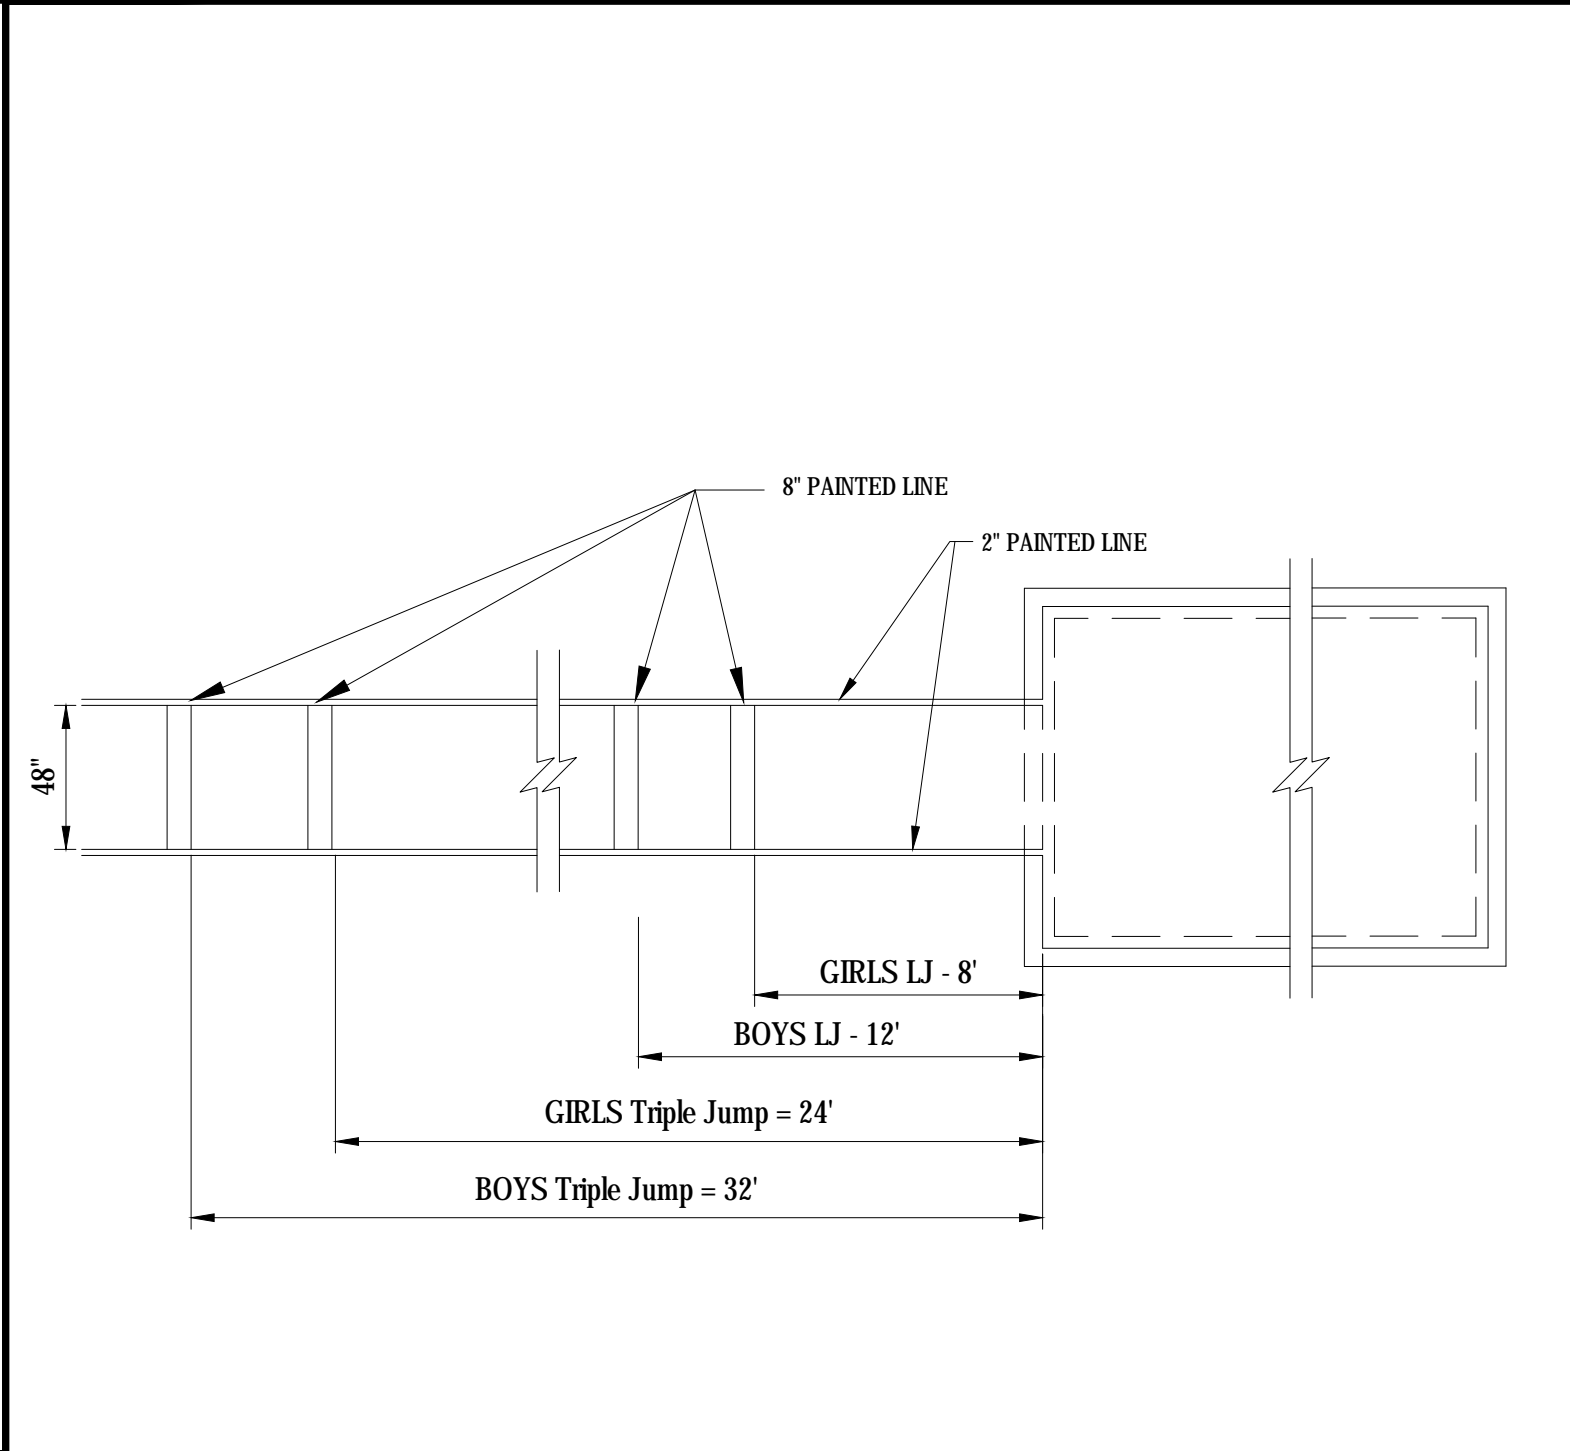


05 LONG/TRIPLE JUMP - PLAN VIEW
SCALE: NTS

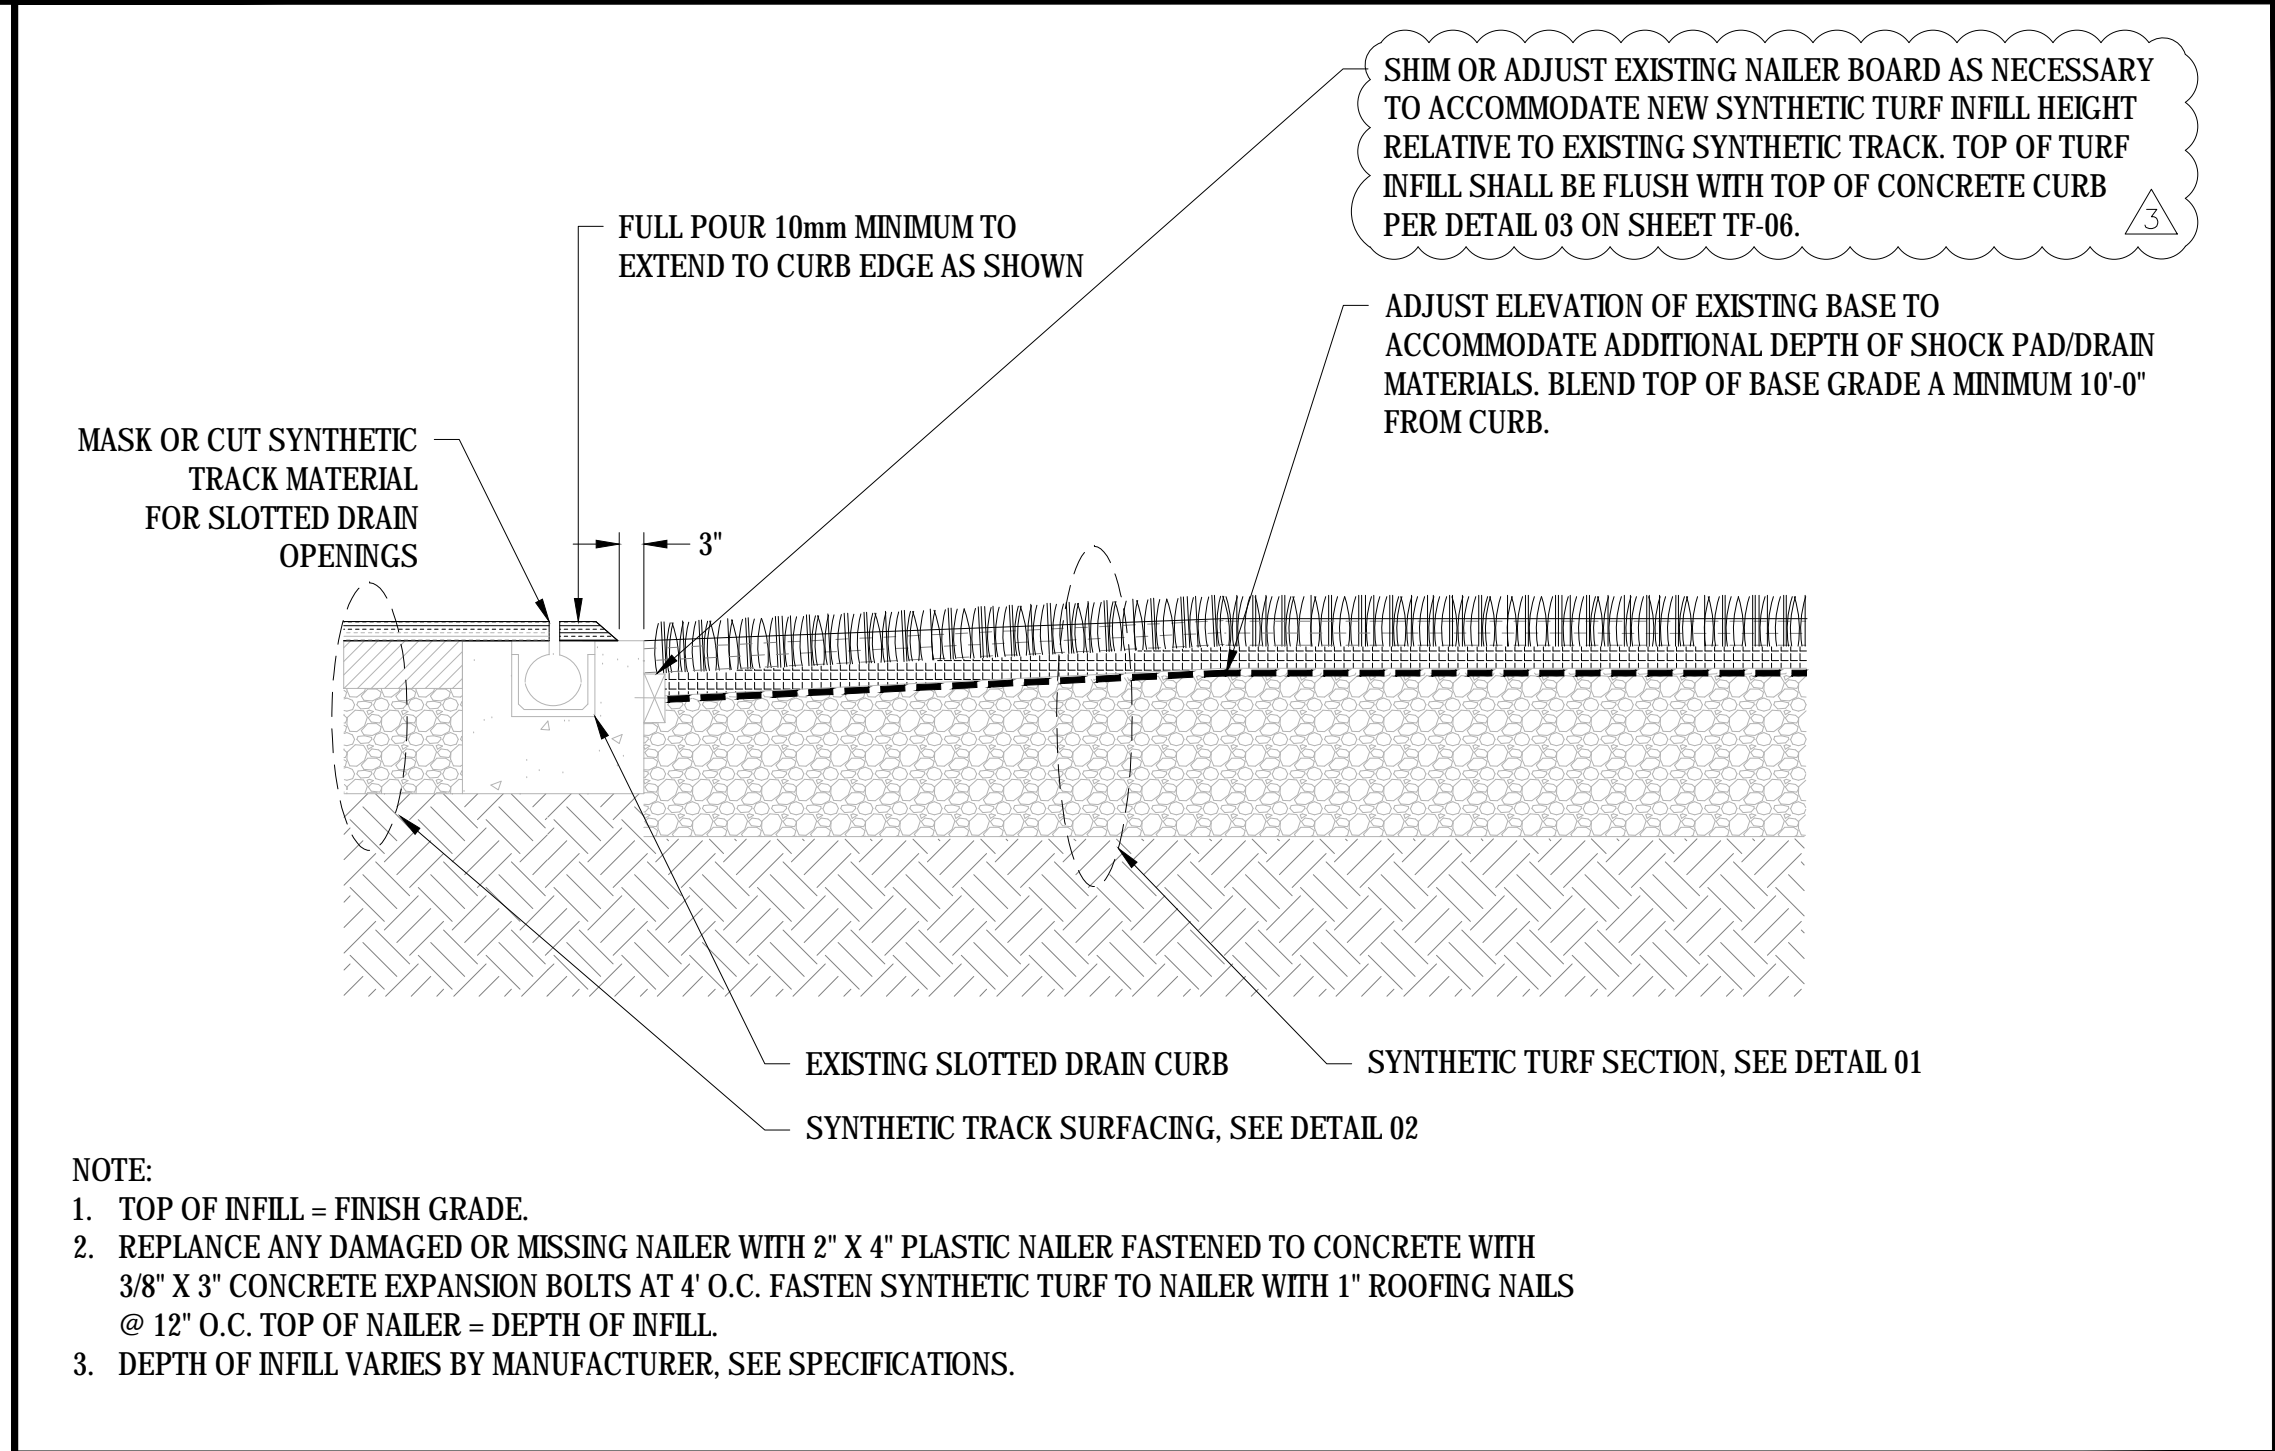


06 SYNTHETIC SURFACING AT SLOTTED DRAIN
SCALE: NTS

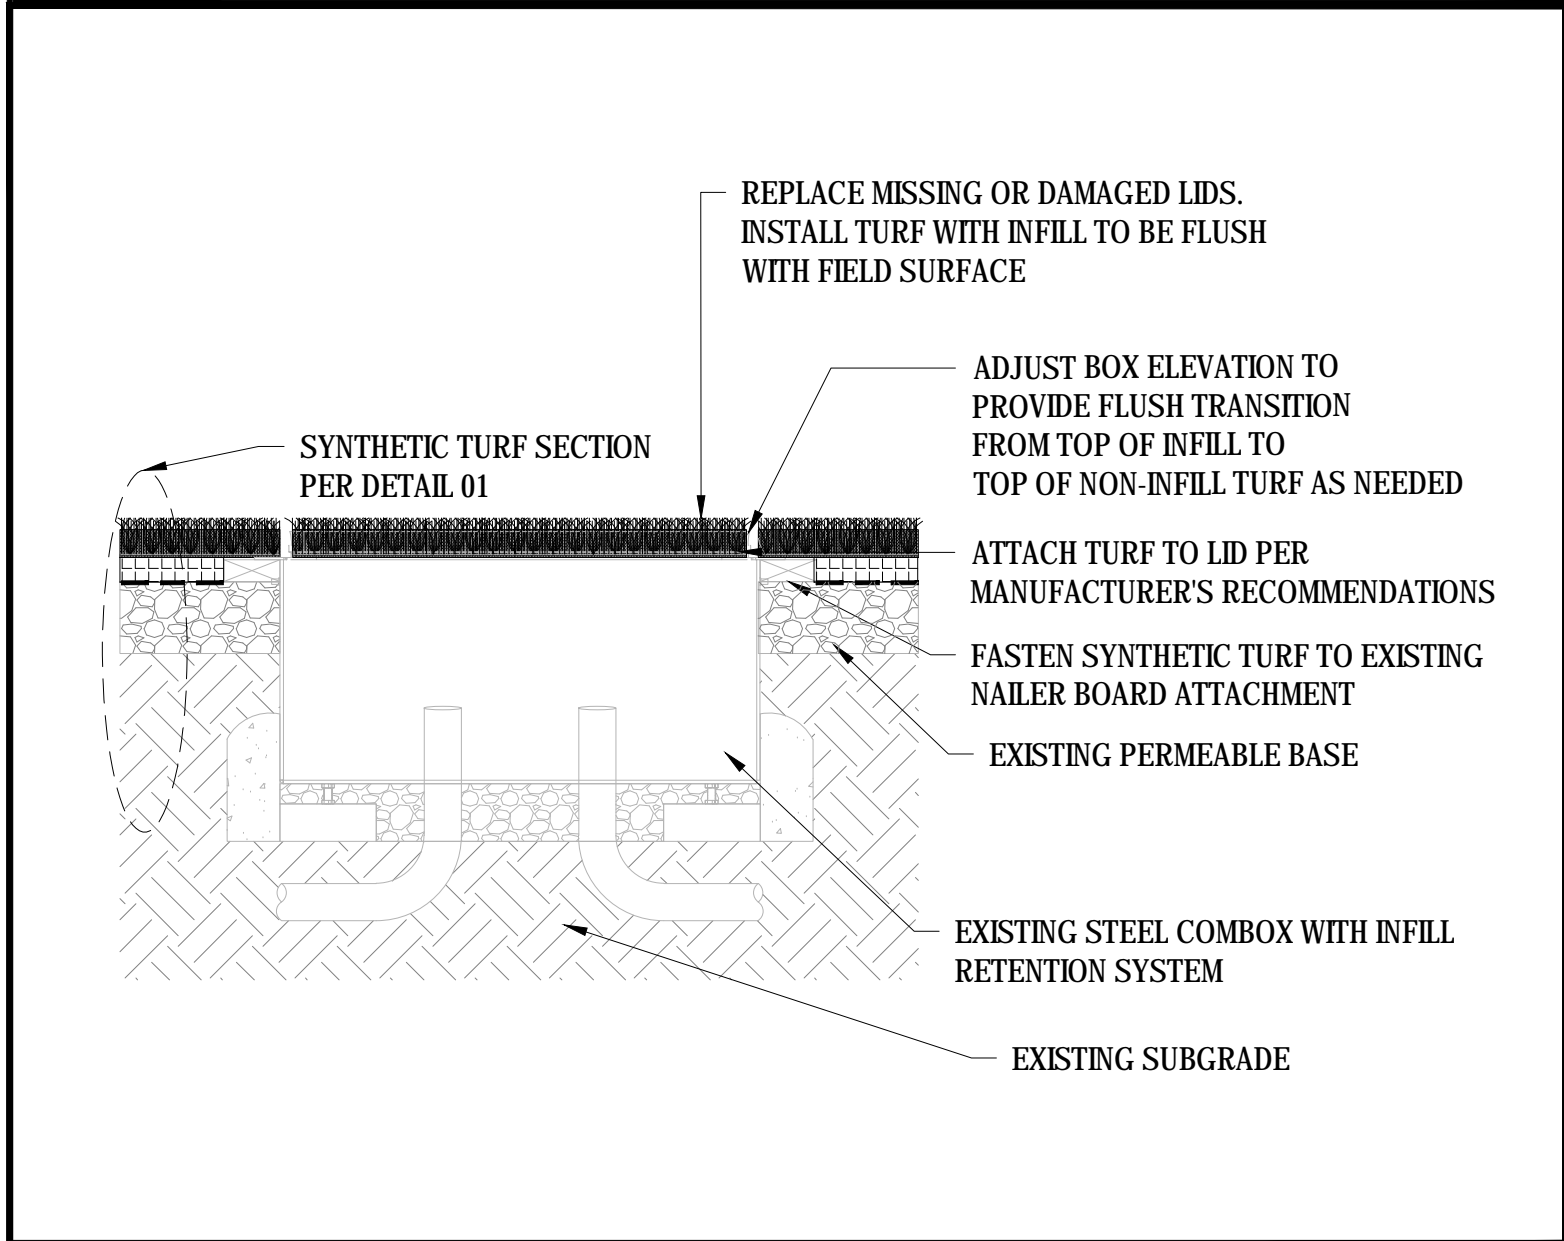


07 EXISTING COMBOX IN SYNTHETIC TURF
SCALE: NTS

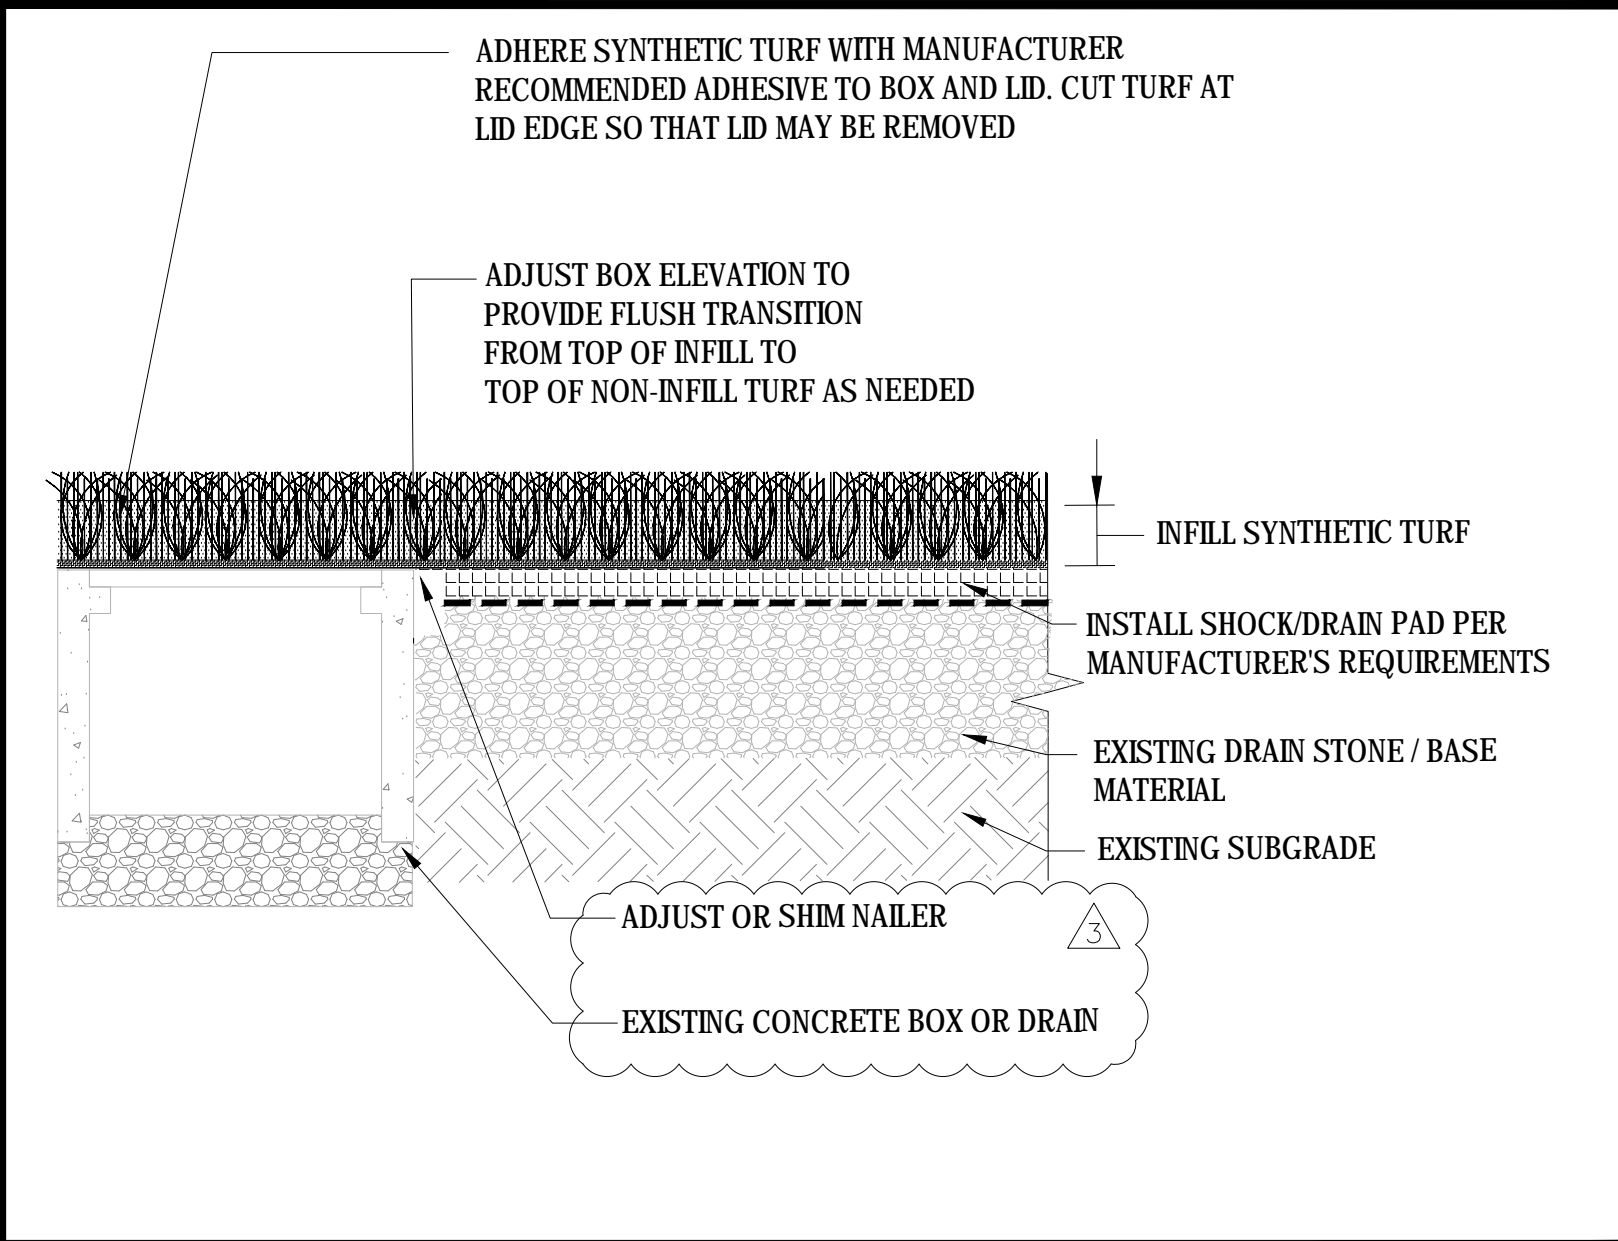

08 EXISTING CONCRETE BOX IN SYNTHETIC TURF
SCALE: NTS

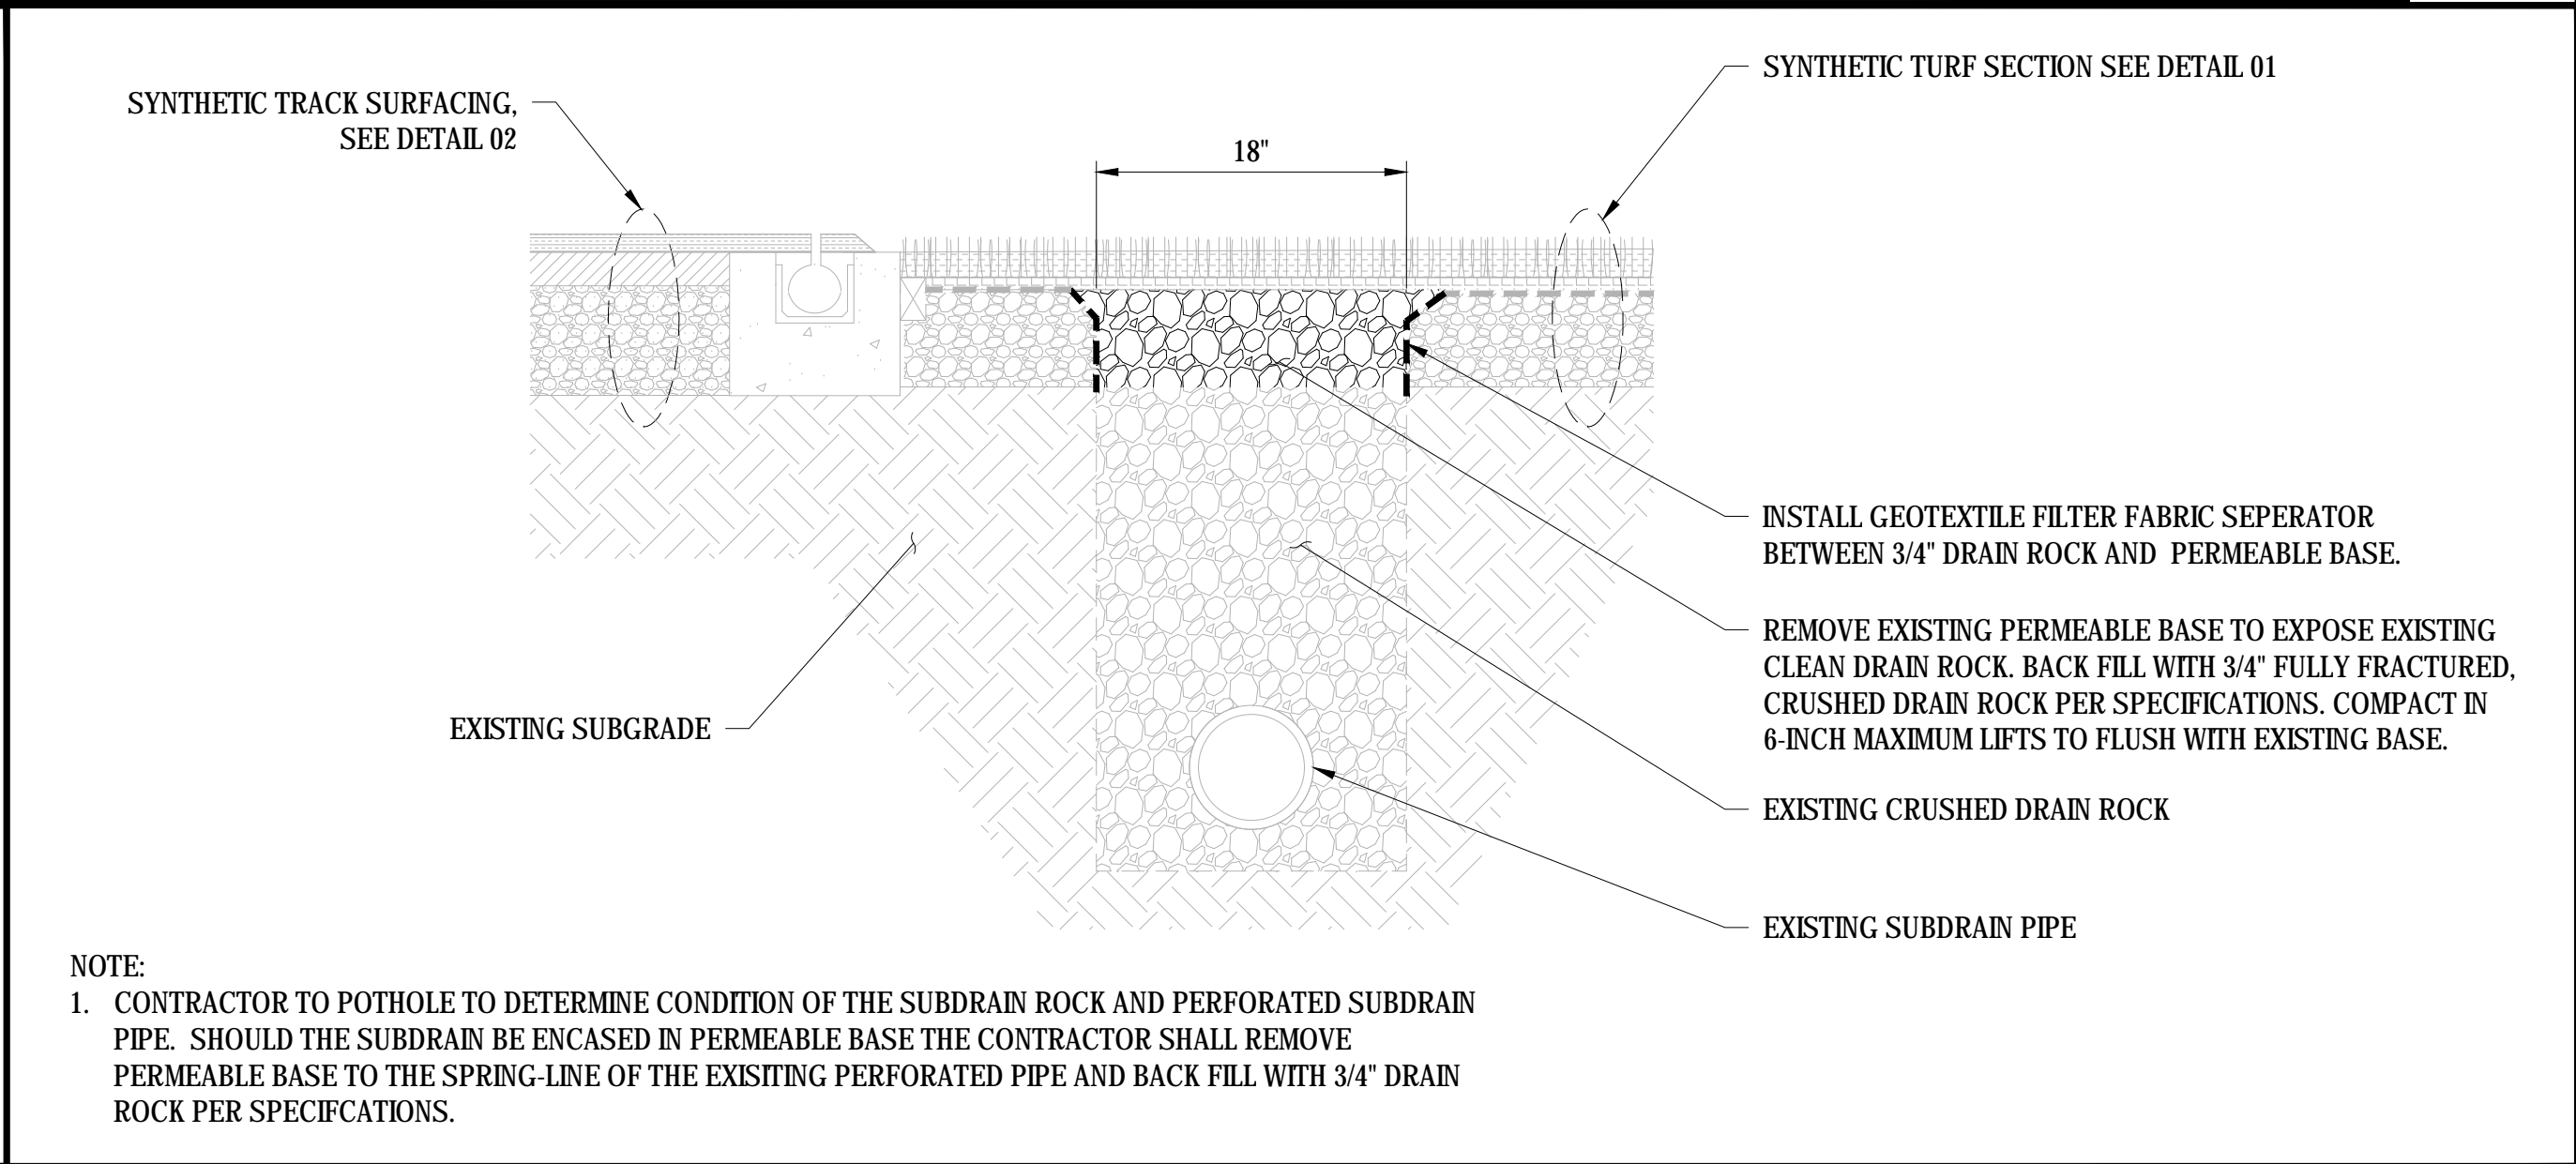

09 SUBDRAIN REPAIR
SCALE: NTS

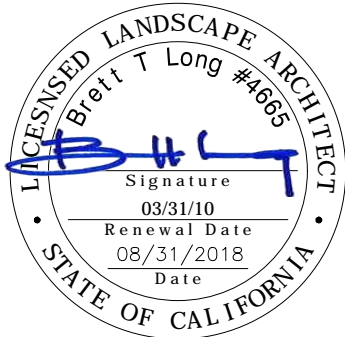

REV.	
1	ADDENDA 1 8/31/2018
2	ADDENDA 2 8/31/2018
3	ADDENDA 3 9/14/2018

OAK GROVE HIGH SCHOOL
TRACK & FIELD RESURFACING
285 Blossom Hill Road
San Jose, CA




SCALE:	N.T.S.
DESIGNED:	BTL
DATE:	8/31/2018
DRAWN:	-
PROJ.	18-120
APPROVED:	

DETAILS

DWG. NO.

TF-05

This plan document set is the sole property of Lloyd Consulting Group, LLC. No alterations to these plans, other than adding "as-built" information, are allowed by anyone other than authorized Lloyd Consulting Group, LLC employees.

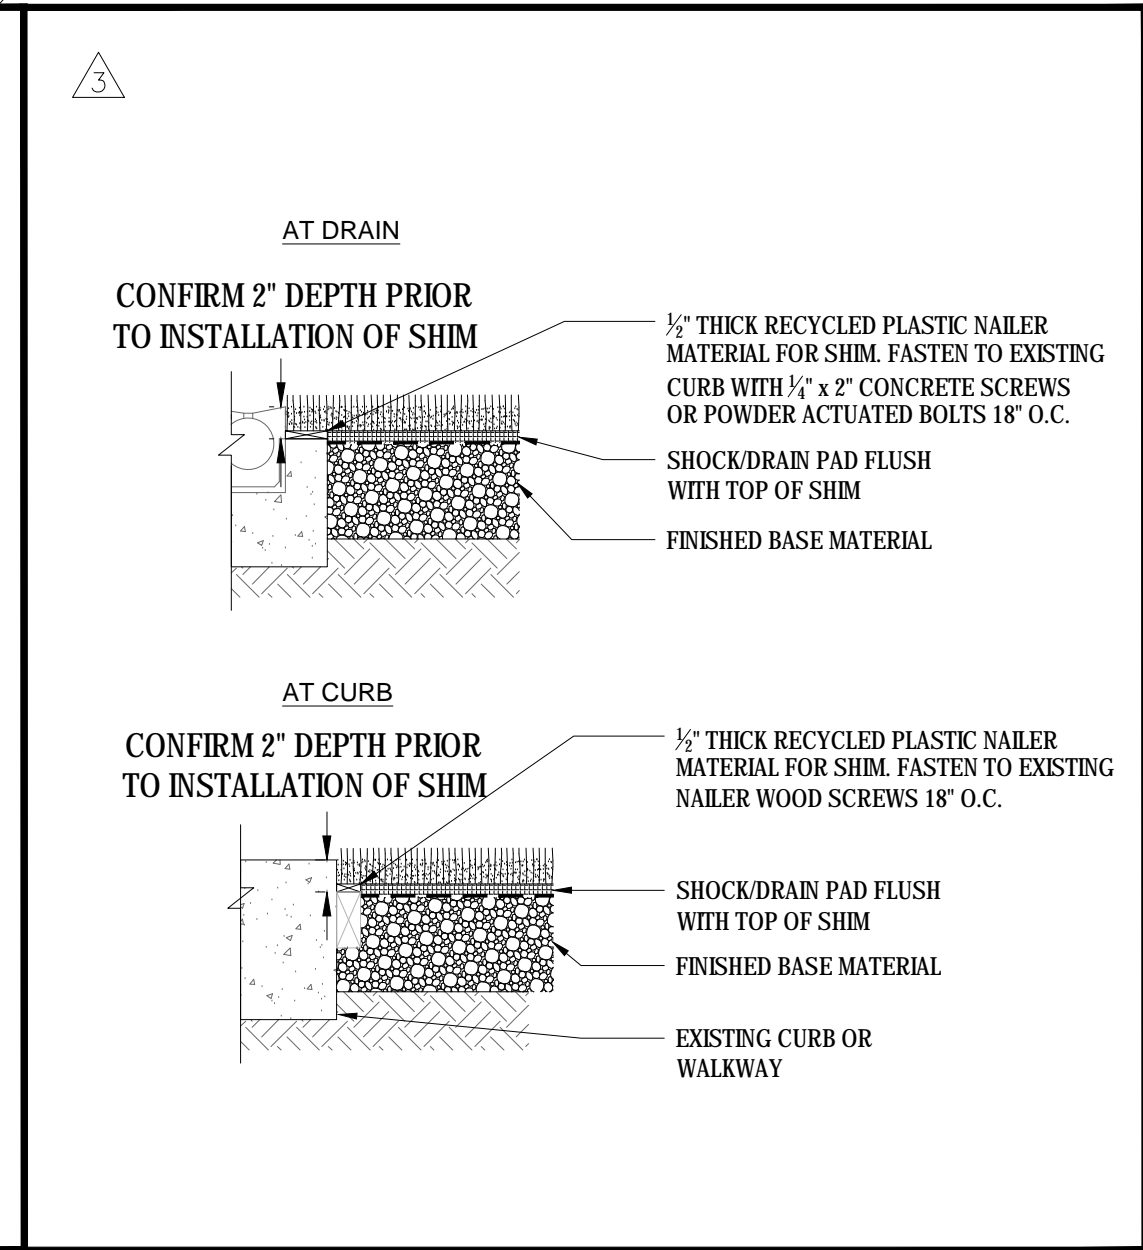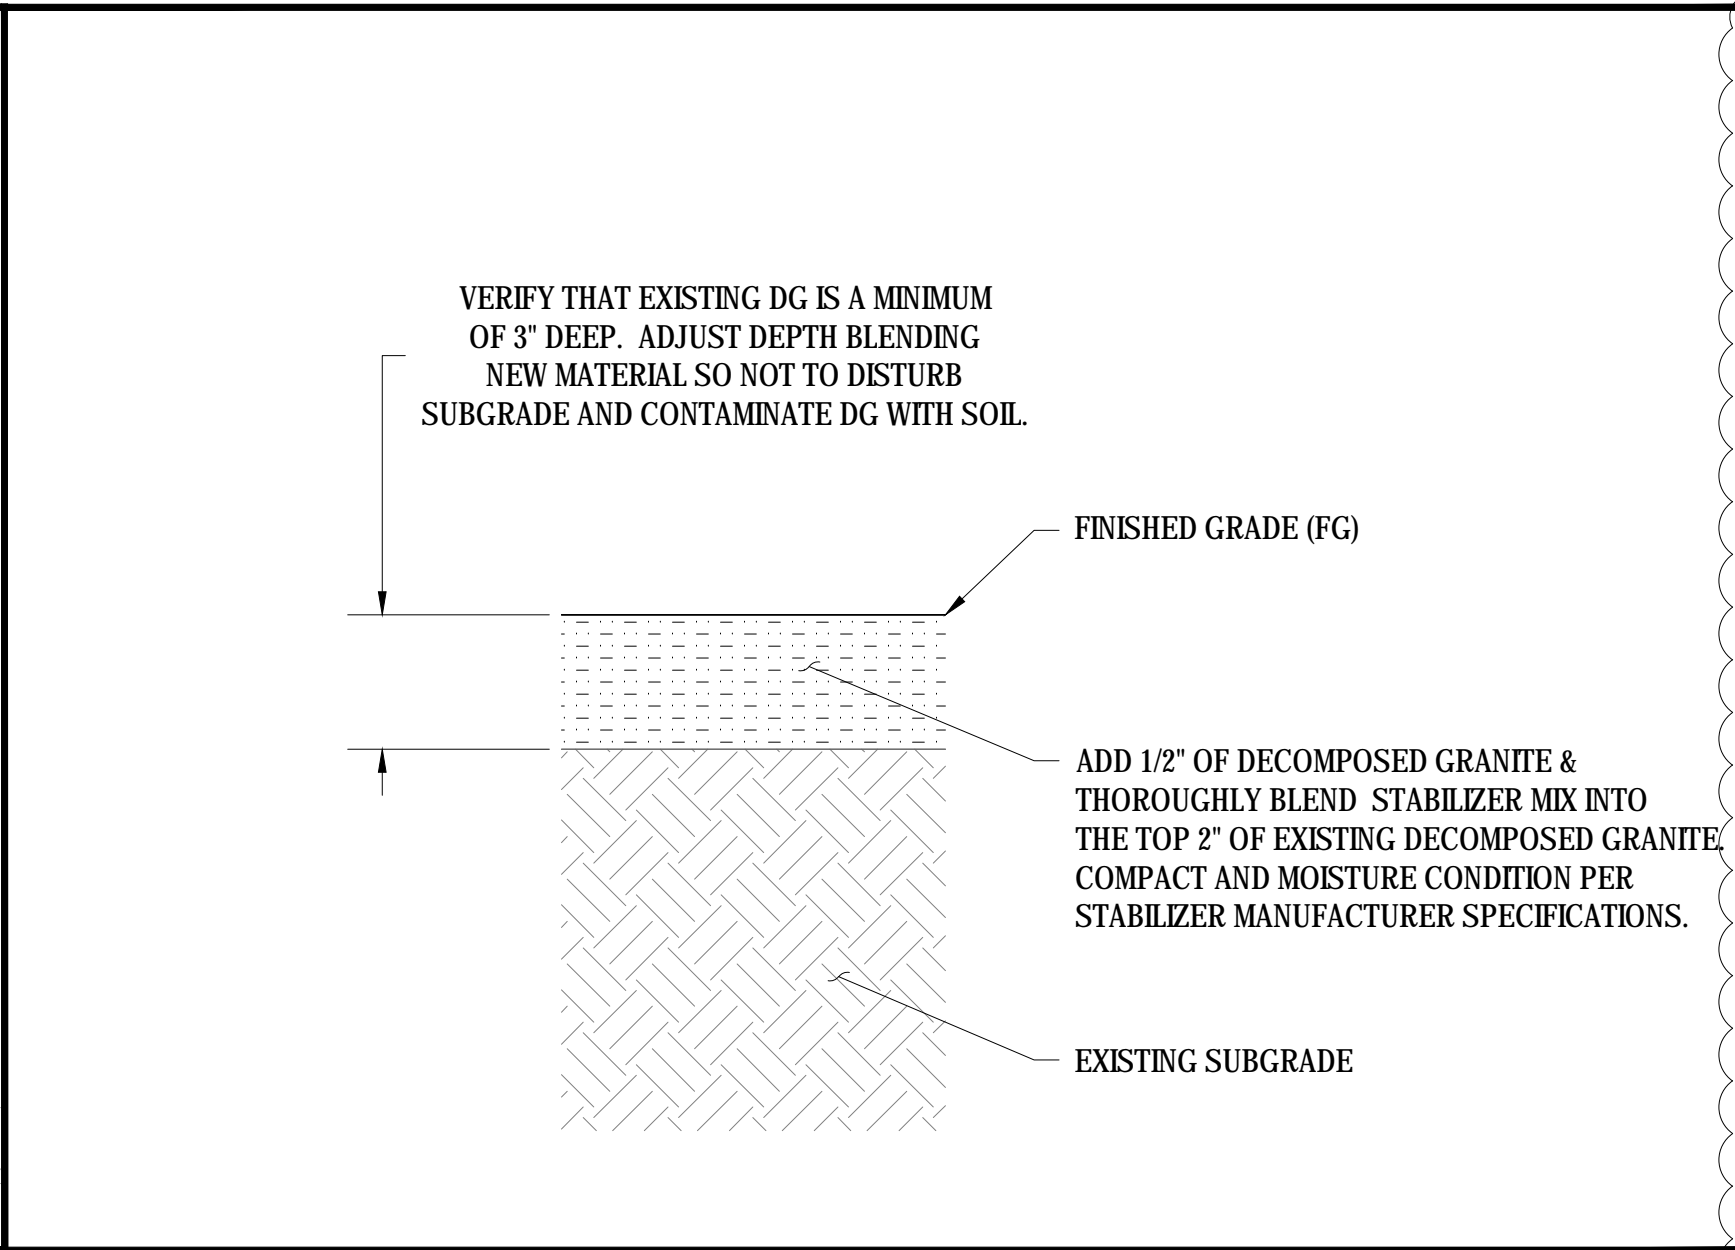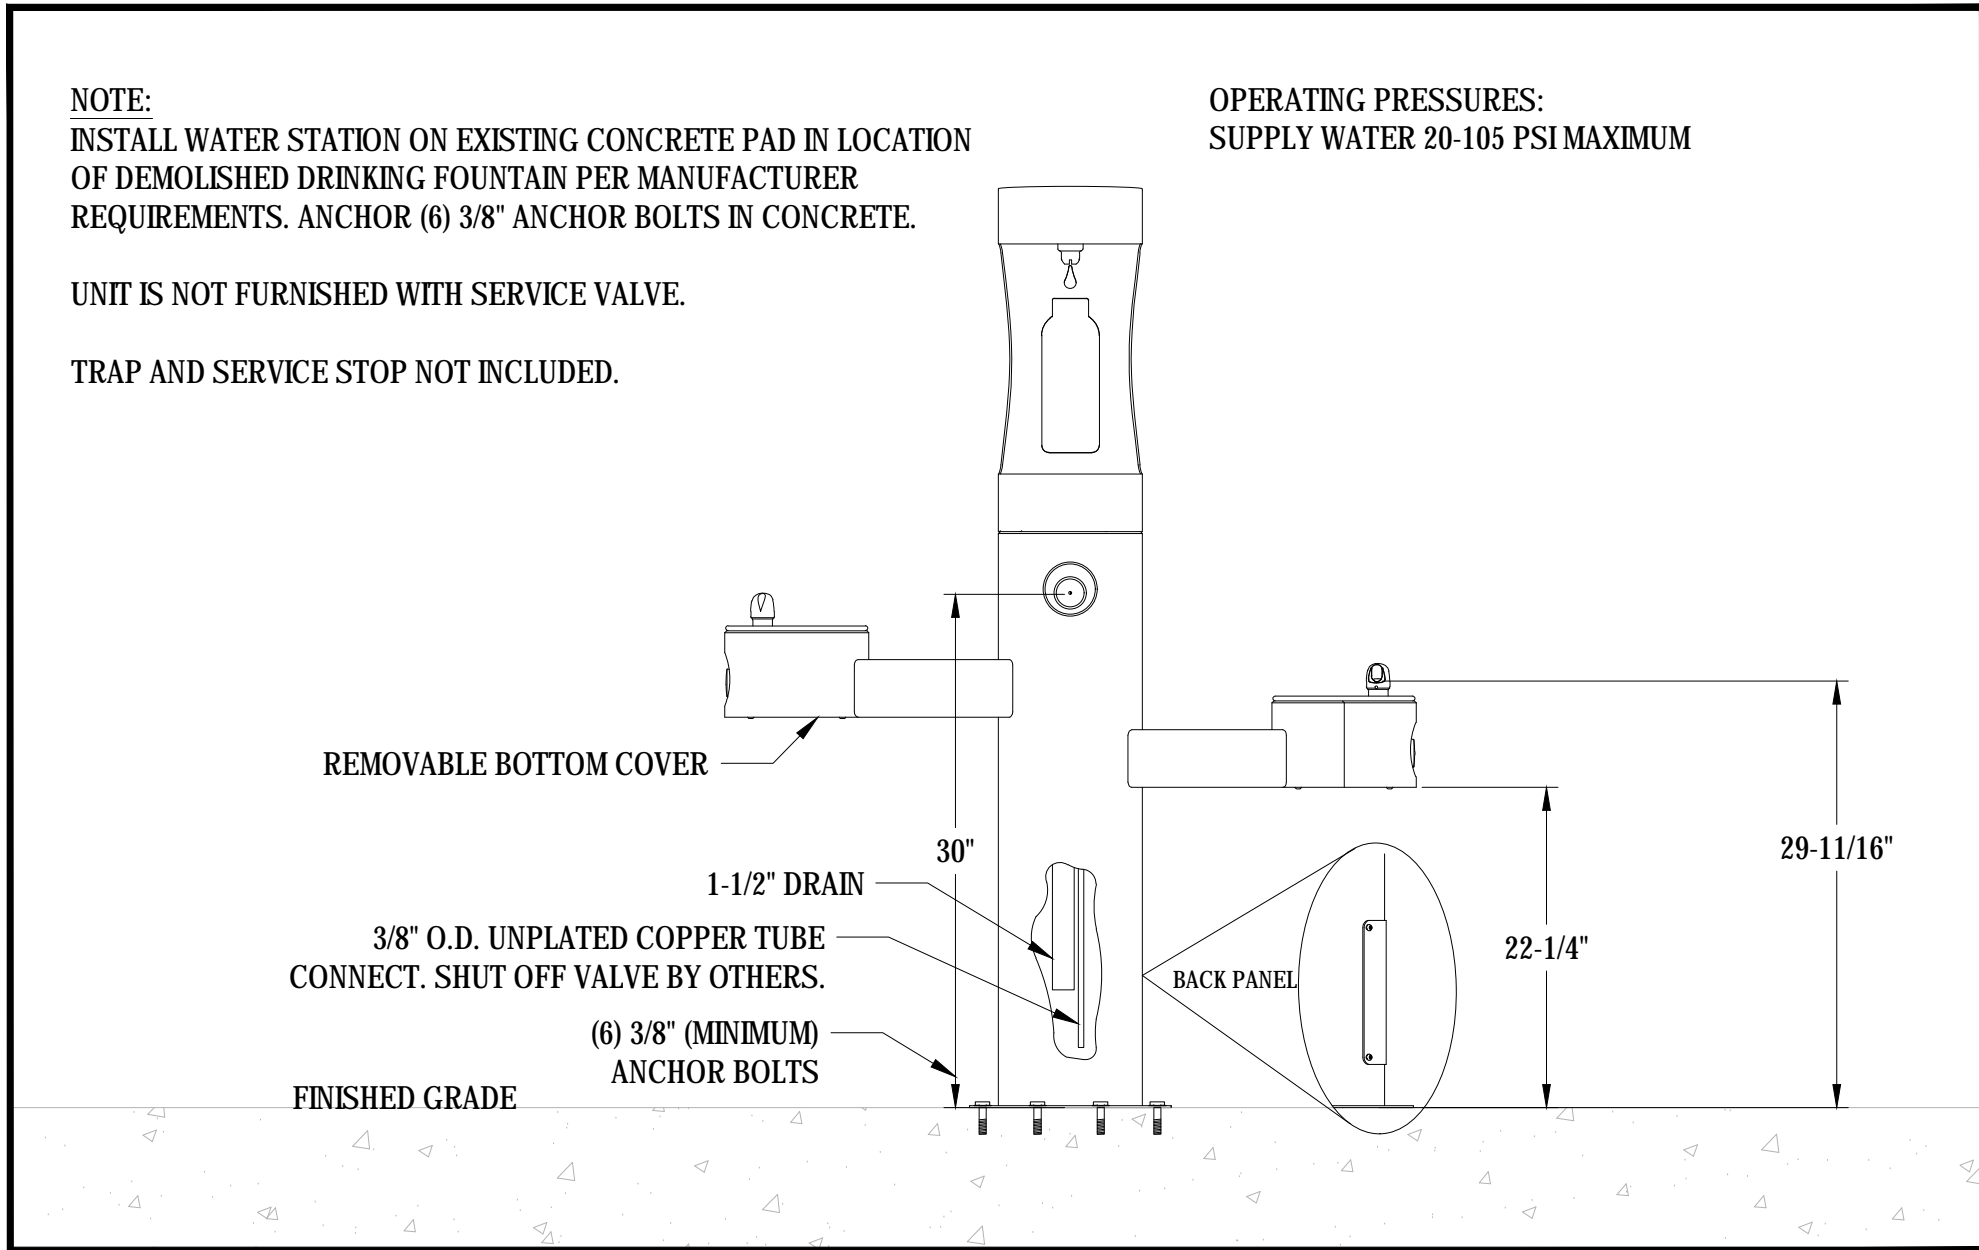

01	DRINKING FOUNTAIN FILLING STATION
	SCALE: NTS

02	DECOMPOSED GRANITE SURFACING
	SCALE: NTS

03	TURF NAILER SHIM
	SCALE: NTS



REV.		
1	ADDENDA 1	8/31/2018
2	ADDENDA 2	8/31/2018
3	ADDENDA 3	9/14/2018

OAK GROVE HIGH SCHOOL
TRACK & FIELD RESURFACING
285 Blossom Hill Road
San Jose, CA


SCALE:	N.T.S.
DESIGNED:	BTL
DATE:	8/31/2018
DRAWN:	—
PROJ.	18-120
APPROVED:	

DETAILS

DWG. NO.

TF-06

This plan document set is the sole property of Lloyd Consulting Group, LLC. No alterations to these plans, other than adding "as-built" information, are allowed by anyone other than authorized Lloyd Consulting Group, LLC employees.

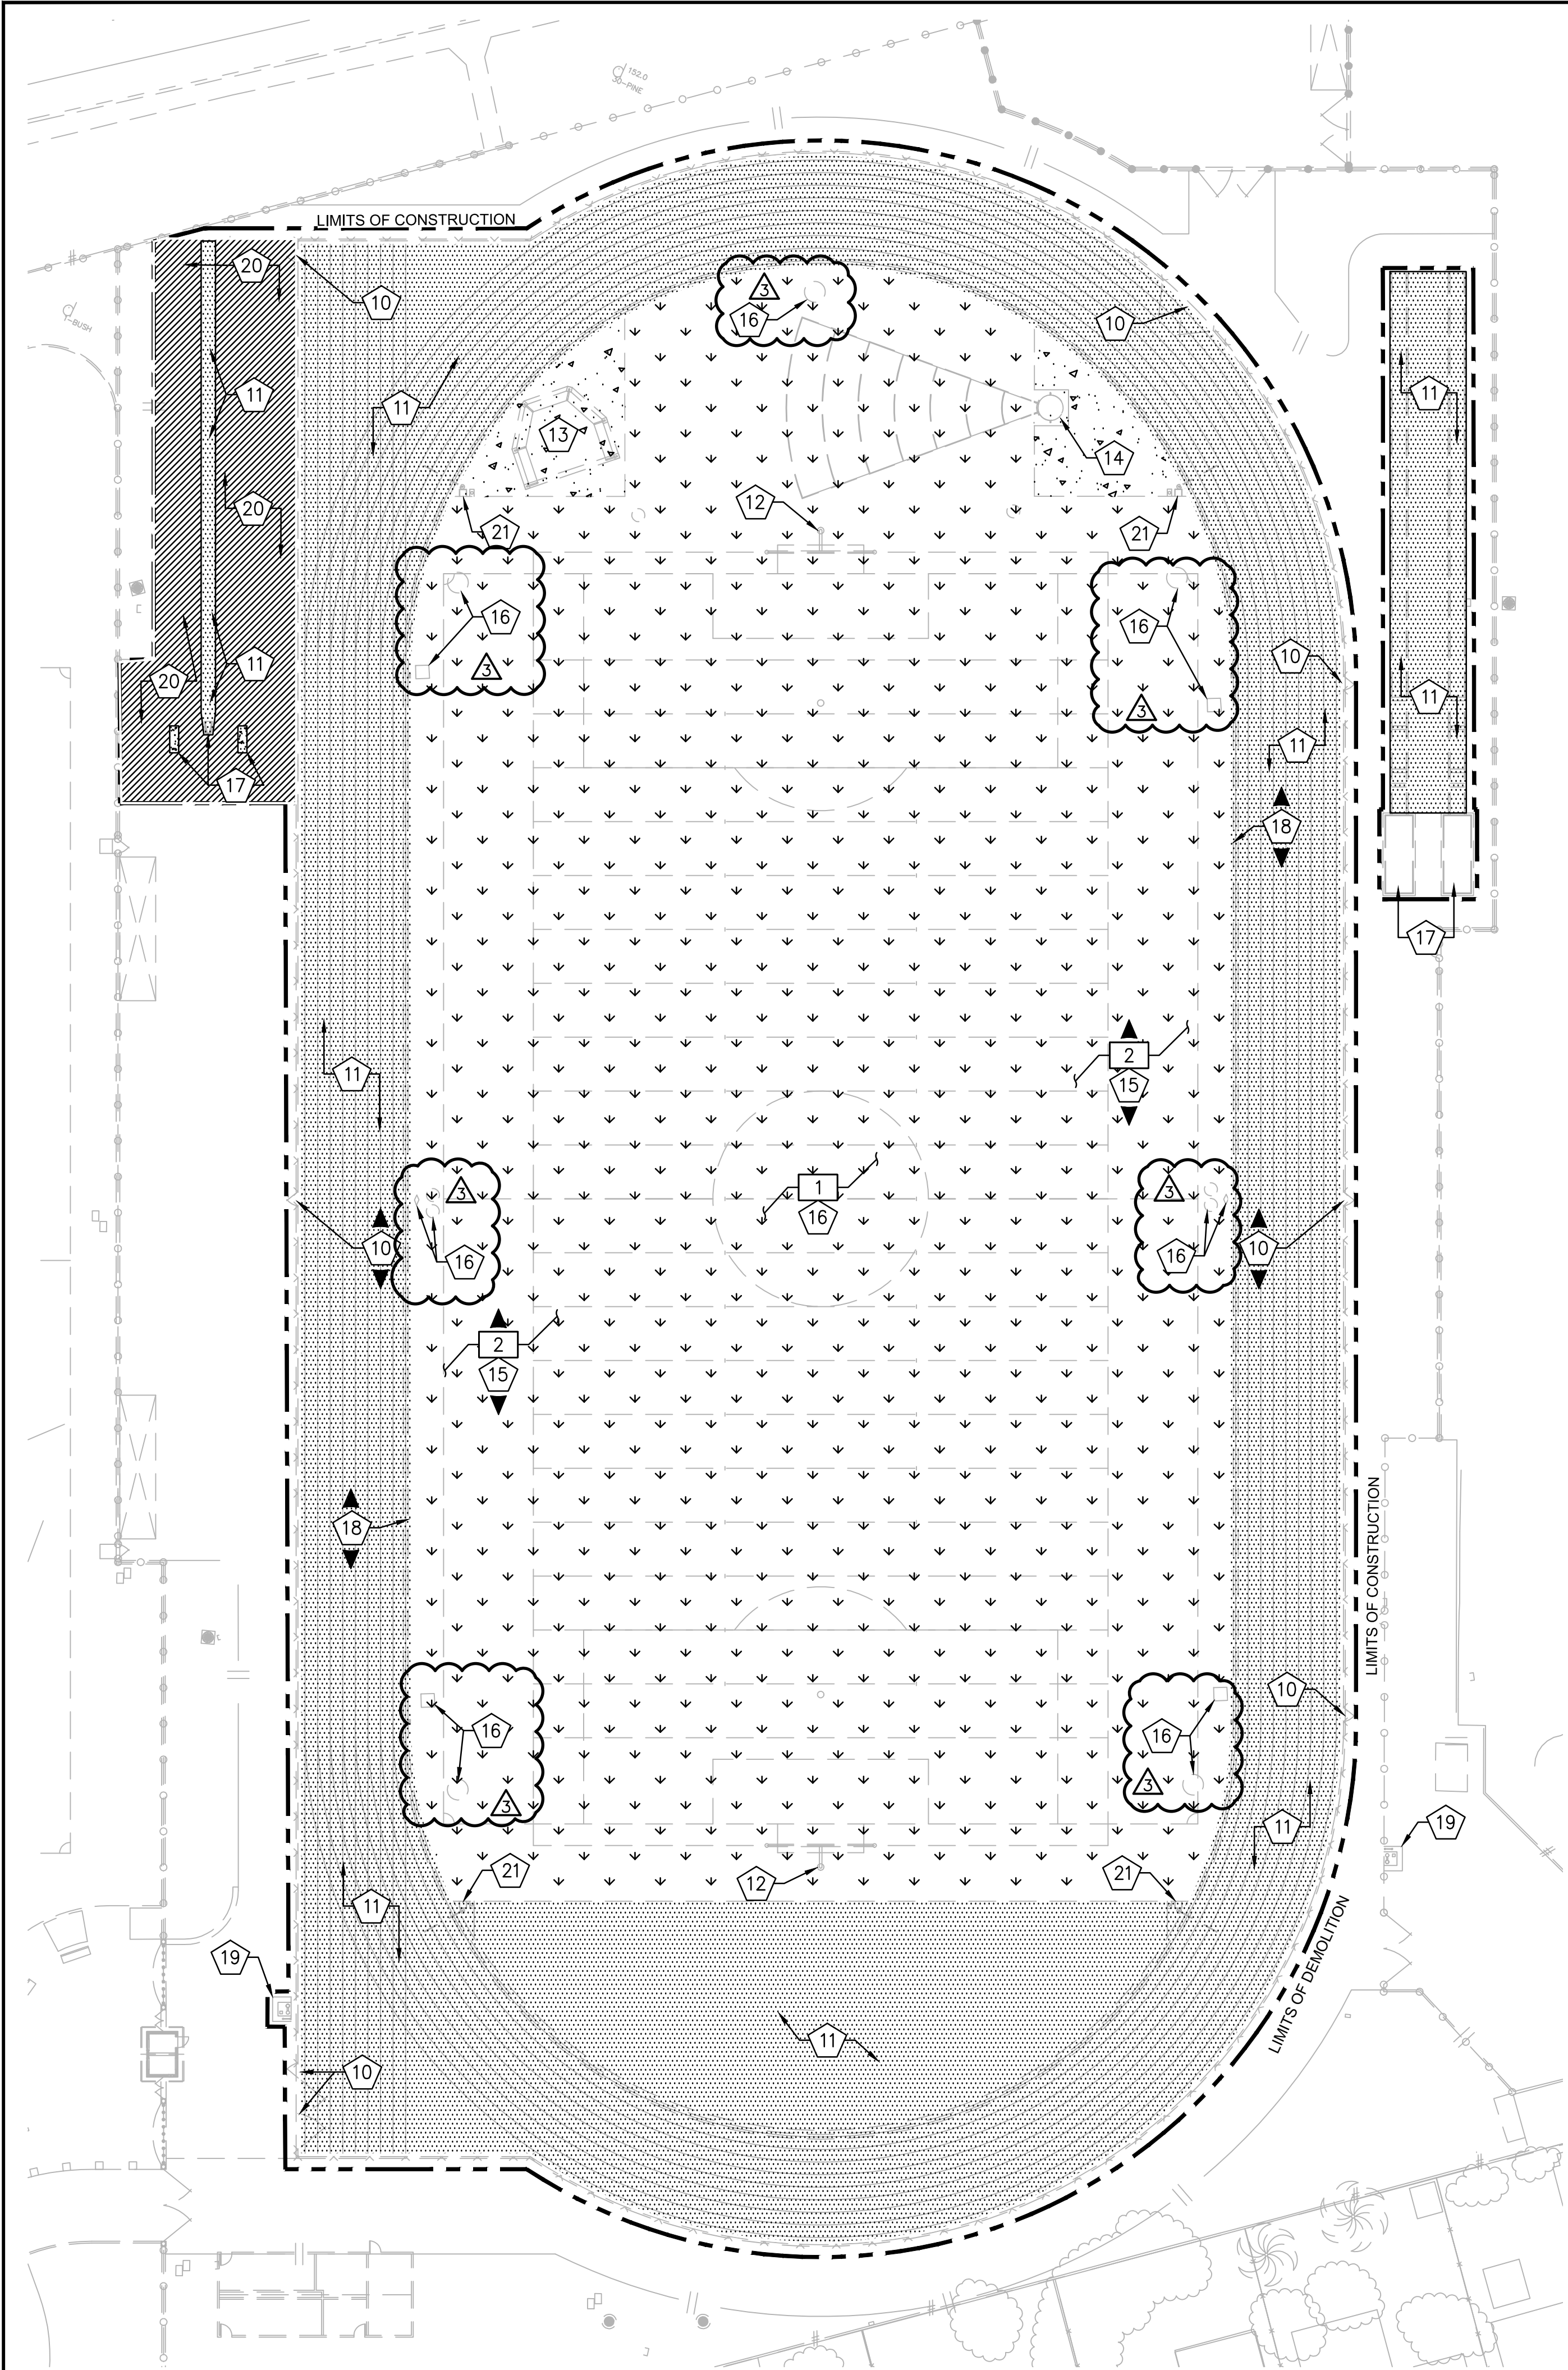

PROTECT IN PLACE NOTES

- 10 PROTECT IN PLACE EXISTING CONCRETE CURB, PERIMETER FENCE, AND GATES.
- 11 PROTECT IN PLACE EXISTING TRACK SURFACE AND ASPHALT BASE. CONTRACTOR TO CLEAN SURFACE OF ALL DEBRIS. THE CONTRACTOR MUST THOROUGHLY INSPECT ENTIRE SURFACE AND REPAIR HOLES, CHIPS, CRACKS, BUMPS AND DIPS. REPAIR METHODS ARE TO BE SUBMITTED AND APPROVED BY ENGINEER PRIOR TO IMPLEMENTATION. CONTRACTOR MUST NOTIFY ENGINEER OF ANY DEFECTS WHICH MAY AFFECT THE LONG TERM STABILITY AND DURABILITY OF PAVEMENT AND TRACK SURFACING.
- 12 PROTECT IN PLACE EXISTING FOOTBALL GOAL POSTS.
- 13 PROTECT IN PLACE EXISTING DISCUS THROWING PAD AND ASSOCIATED CONCRETE.
- 14 PROTECT IN PLACE EXISTING SHOT PUT THROWING PAD AND ASSOCIATED CONCRETE.
- 15 VERIFY LOCATIONS AND PROTECT IN PLACE ALL EXISTING IRRIGATION AND/OR COMMUNICATION BOXES TO ACCOMMODATE RESURFACING.
- 16 PROTECT IN PLACE EXISTING IRRIGATION, DRAINAGE PIPES AND DRAIN INLETS. CONTRACTOR MUST VERIFY EXISTING IRRIGATION AND/OR DRAINAGE LOCATIONS AND MAINTAIN FLOW AND AUTOMATED CONTROL SERVICE TO ANY ADJACENT LANDSCAPE OR DRAINAGE AREAS DURING AND AFTER CONSTRUCTION.
- 17 PROTECT IN PLACE EXISTING SAND PIT/VAULT BOX AND ASSOCIATED CONCRETE.
- 18 PROTECT IN PLACE EXISTING SLOT DRAIN. CLEAN AND FLUSH ALL DRAINS PER SPECIFICATIONS.
- 19 PROTECT IN PLACE EXISTING DRINKING FOUNTAINS. CONTRACTOR TO VERIFY LOCATION.
- 20 PROTECT IN PLACE EXISTING SYNTHETIC SURFACING. CLEAN AND PREPARE AREA FOR SPRAY COAT FINISH.
- 21 PROTECT IN PLACE EXISTING LANE GATES.

DEMOLITION NOTES

- 1 REMOVE AND DISPOSE OF EXISTING SYNTHETIC TURF AND INFILL. DISPOSE OF TURF AND INFILL PER LOCAL CODES AND REQUIREMENTS.
- 2 REMOVE AND DISPOSE OF EXISTING SYNTHETIC TURF FROM ALL IRRIGATION AND COMMUNICATION BOXES. ACTUAL BOX LOCATIONS NOT SHOWN. CONTRACTOR MUST LOCATE ALL BOXES.

LEGEND

- EXISTING TRACK SURFACE TO BE PROTECTED
- EXISTING SYNTHETIC TURF PLAYING FIELD TO BE REMOVED
- EXISTING CONCRETE TO BE PROTECTED IN PLACE
- EXISTING SPRAY MAT SURFACE TO BE REPLACED
- LIMITS OF CONSTRUCTION
- KEYNOTE CALLOUT SYMBOL

GENERAL NOTES:

- CONTRACTOR MUST REMOVE AND DISPOSE OF ALL WEEDS, LOOSE MATERIALS, AND THOROUGHLY CLEAN THE TRACK/RUNWAY, DG AREAS TO RECEIVE THE NEW SURFACE.
- AT THE CONCLUSION OF THE REPAIRS AND PREPARATION NO EXPOSED CONCRETE SURFACES SHALL BE VISIBLE ALONG THE PERIMETER AND OR EDGES OF ANY AREAS INTENDED FOR A SYNTHETIC TRACK AND FIELD RUNNING OR JUMPING SURFACE.
- EXISTING STORM DRAIN FACILITIES WITHIN THE LIMITS OF CONSTRUCTION MUST BE PROTECTED FROM CONSTRUCTION DEBRIS INTRUSION AND MUST BE FLUSHED OUT AND CLEANED BY THE CONTRACTOR.
- THE CONTRACTOR SHALL PROVIDE AND INSTALL EROSION CONTROL ITEMS SUCH AS SILT FENCING, HAY BALES, STABILIZED CONSTRUCTION ENTRANCES, AND INLET SEDIMENT TRAPS AS REQUIRED BY LOCAL CODE. THE CONTRACTOR IS RESPONSIBLE TO PROVIDE ANY EROSION CONTROL PLANS REQUIRED BY GOVERNMENT AGENCIES, AND OBTAIN ANY REQUIRED PERMITS.
- CONTRACTOR IS RESPONSIBLE FOR MAINTAINING IRRIGATION SERVICE TO EXISTING LANDSCAPE MATERIAL TO REMAIN AND TO ADJACENT FIELDS BOTH DURING AND AFTER CONSTRUCTION.
- THE CONTRACTOR MUST CONTACT LOCAL UTILITY LOCATION SERVICES PRIOR TO CONSTRUCTION.
- THE CONTRACTOR MUST PROTECT IN PLACE ALL EXISTING UTILITIES. THE CONTRACTOR IS RESPONSIBLE FOR REPAIR OR REPLACEMENT OF UTILITIES DAMAGED DURING CONSTRUCTION.
- THE CONTRACTOR IS RESPONSIBLE FOR RENOVATING ALL INFIELD BOXES PER PLAN NOTES AND DETAILS.



REV.		
ADDENDA 1	8/31/2018	
ADDENDA 2	8/31/2018	
ADDENDA 3	9/14/2018	


ANDREW P. HILL HIGH SCHOOL
TRACK & FIELD RESURFACING
3200 Senter Road
San Jose, CA

SCALE:	1"=30'
DESIGNED:	BTL
DATE:	8/31/2018
DRAWN:	ZTP
PROJ.	18-120
APPROVED:	


DEMOLITION PLAN

DWG. NO.

TF-02

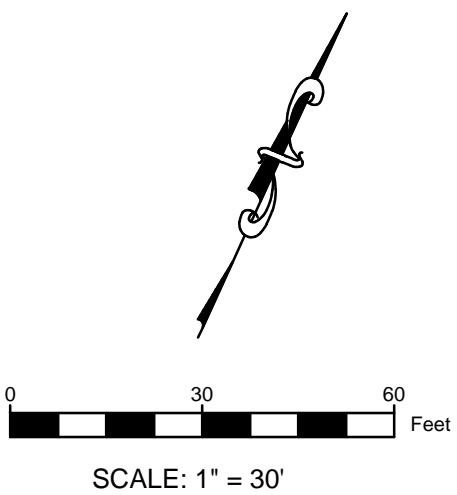

This plan document set is the sole property of Lloyd Consulting Group, LLC. No alterations to these plans, other than adding "as-built" information, are allowed by anyone other than authorized Lloyd Consulting Group, LLC employees.

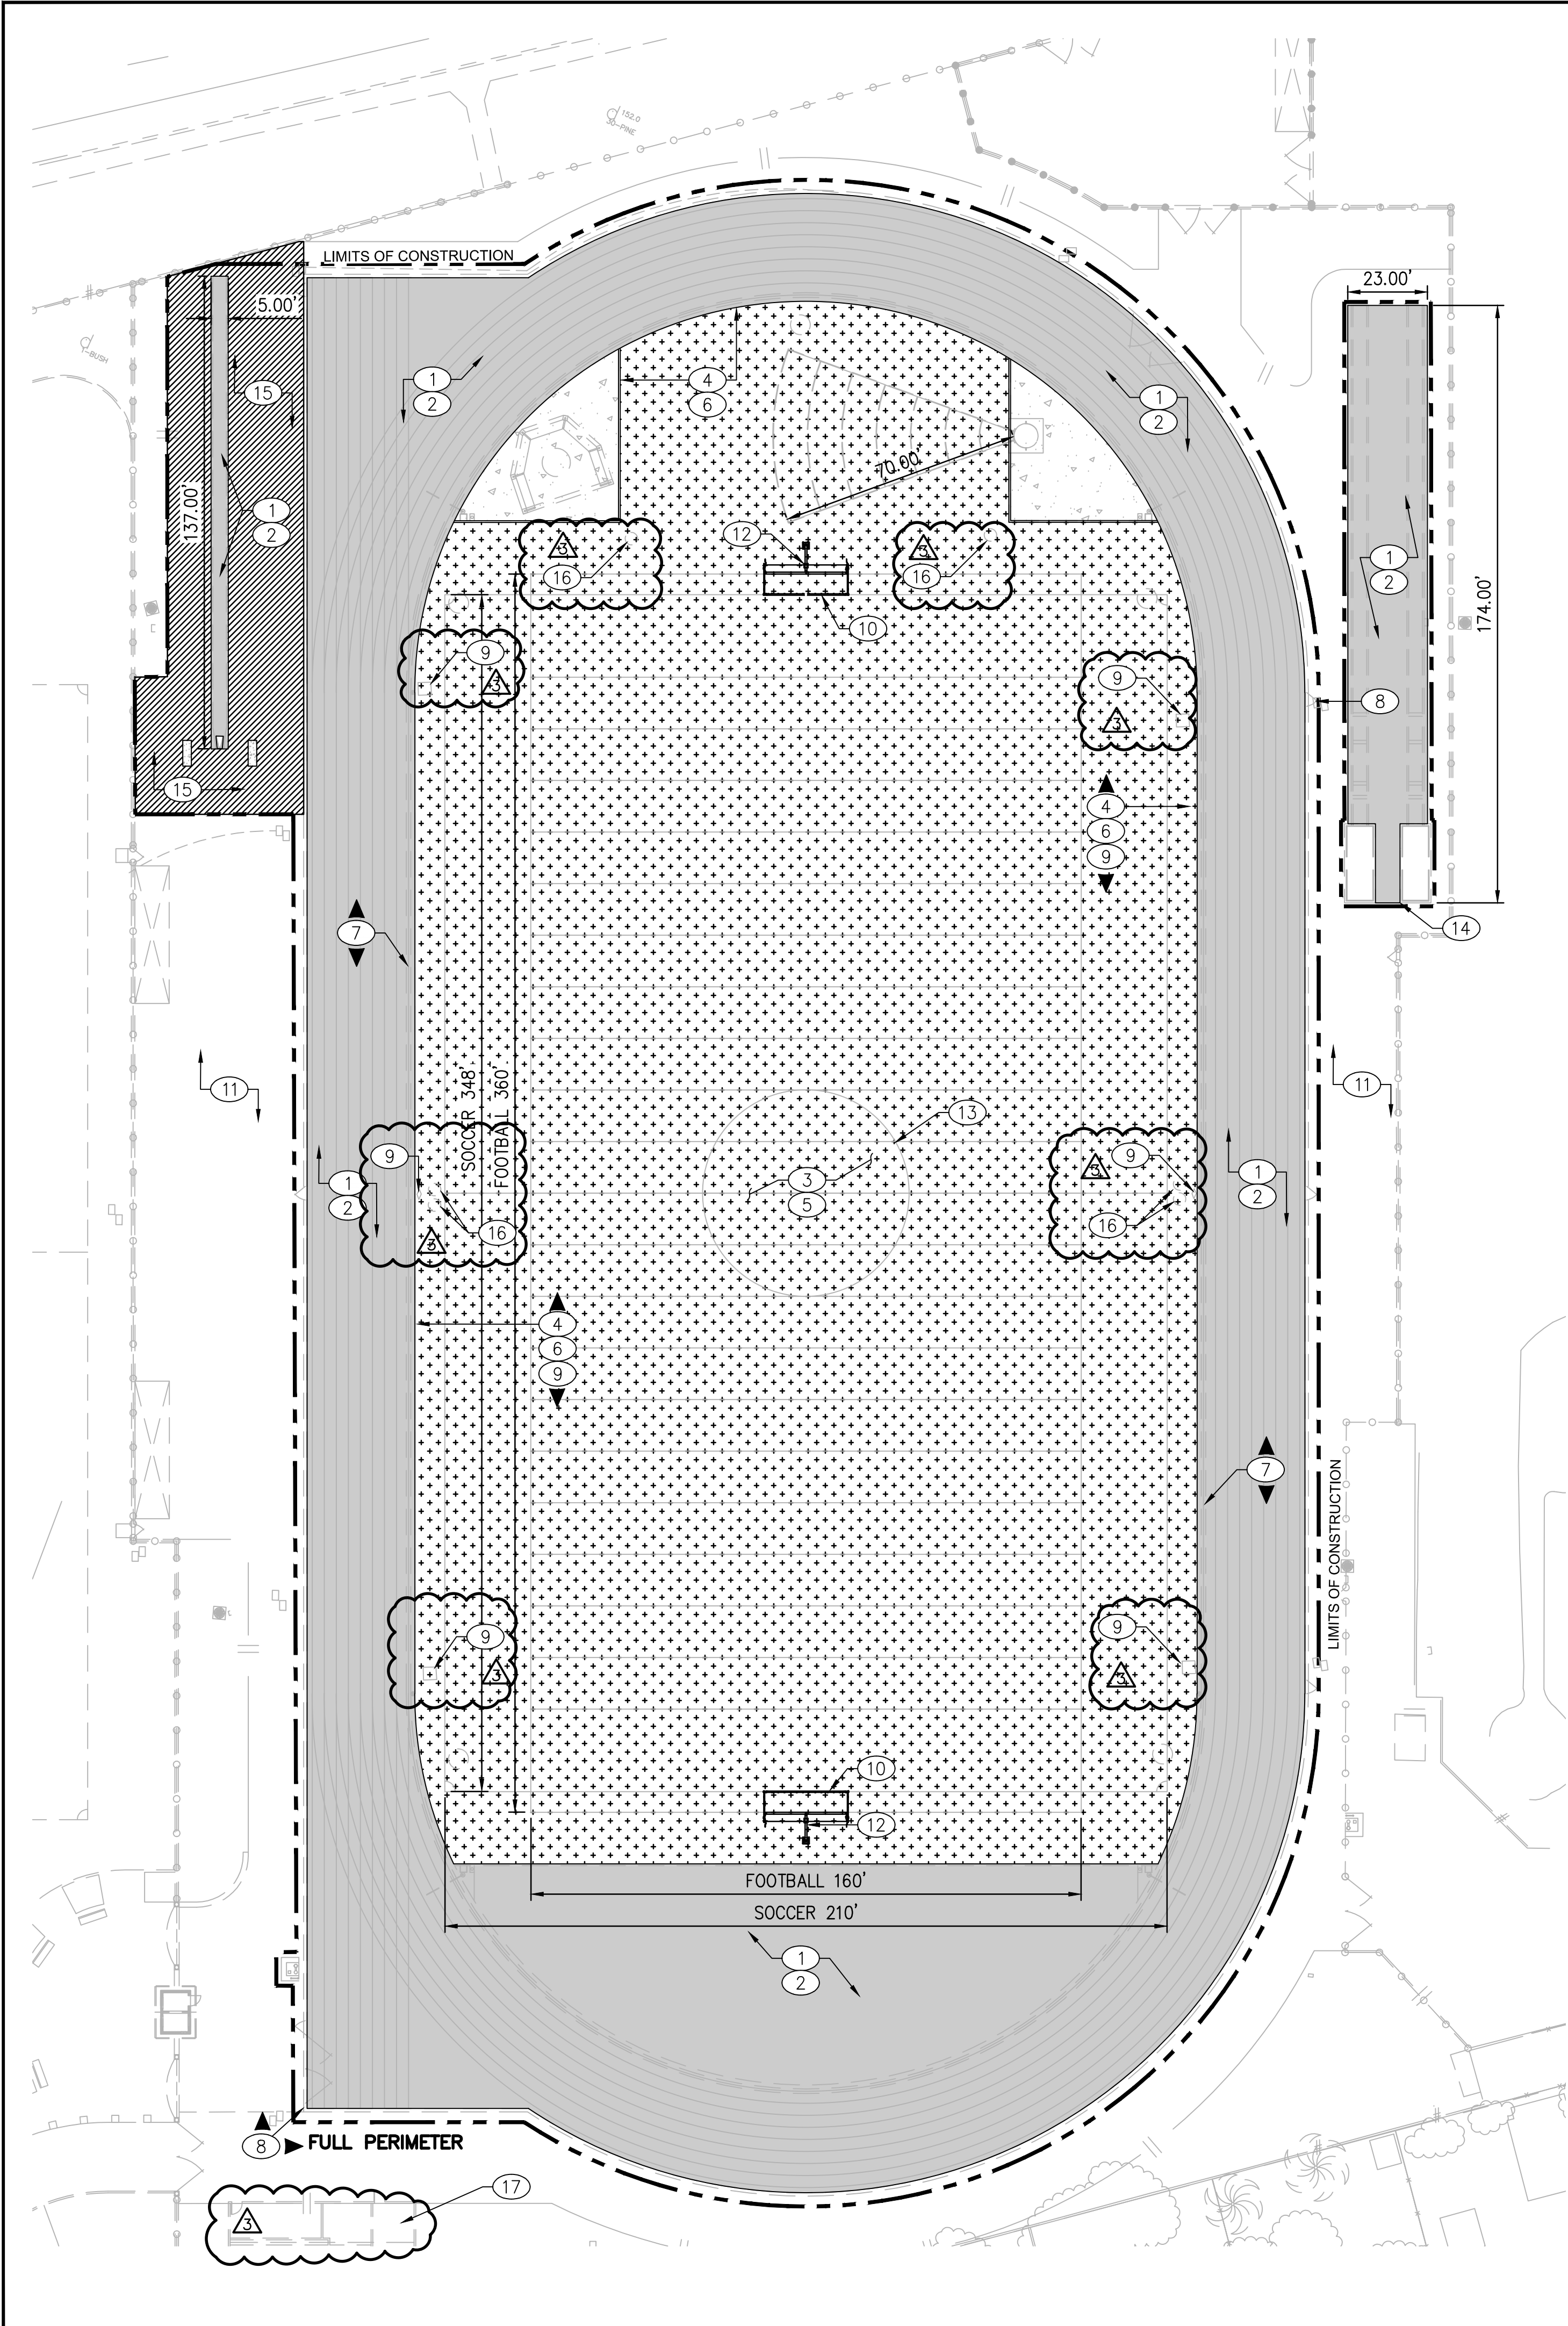

SURFACING NOTES:


1. INSTALL SYNTHETIC TRACK OVERLAY ON EXISTING RUNNING TRACK, D-ZONES, LONG/TRIPLE JUMP RUNWAYS & LANDING PIT COVERS PER DETAIL 02 ON SHEET TF-05.
2. STRIPE TRACK AND RUNWAYS PER NFHS REQUIREMENTS AND PER SPECIFICATIONS. SEE DETAIL 04 ON SHEET TF-05.
3. PRIOR TO SHOCK PAD/DRAIN LAYER INSTALLATION THE CONTRACTOR MUST CORRECT ANY RIDGES OR DEPRESSIONS IN PLAYING FIELD BASE THAT DO NOT MEET GRADING TOLERANCES PER THE SPECIFICATIONS.
4. ADJUST PLAYING FIELD BASE ELEVATIONS AT FIELD PERIMETER AND ADJUST NAILER BOARD ELEVATIONS TO MAINTAIN SMOOTH/FLUSH TRANSITION BETWEEN TURF AND TRACK SURFACES WITH NO GRADING GAP OR LIP. CONTRACTOR MUST REPLACE DAMAGED NAILER BOARDS. SEE DETAIL 06 ON SHEET TF-05.
5. INSTALL SYNTHETIC TURF SYSTEM WITH SHOCK PAD, DRAIN LAYER AND GEOTEXTILE FABRIC PER DETAIL 01 ON SHEET TF-05.
6. ATTACH SYNTHETIC TURF TO NAILER BOARD PER DETAIL 06 ON SHEET TF-05.
7. ALL SLOT DRAIN INLET OPENINGS TO REMAIN OPEN AND FREE OF SURFACING.
8. REPAIR EXISTING FENCE RAILS AS NEEDED. CLEAN, PRIME AND PAINT POSTS, RAILS & GATES. INSTALL NEW VINYL CLAD FABRIC ON FENCE AND GATES. REPAIR GATES & HARDWARE AS NEEDED. (COLOR BLACK)
9. ADJUST EXISTING COMMUNICATION/ELECTRIC AND IRRIGATION BOXES TO SIT FLUSH WITH SYNTHETIC SURFACING, PER DETAIL 07 AND 08 ON SHEET TF-05.
10. INSTALL SOCCER GOALS WITH ANCHOR WEIGHTS PER SPECIFICATIONS.
11. CONTRACTOR TO PRESSURE WASH AND CLEAN ALL BLEACHERS AT THE END OF CONSTRUCTION.
12. CLEAN AND POWDER COAT GOAL POSTS NEON YELLOW AND REPLACE WIND FLAGS AT TOP OF POSTS PER SPECIFICATIONS.
13. REFER TO SHEET TF-04 FOR FOOTBALL AND SOCCER FIELD STRIPING LAYOUT.
14. CLEAN ALL SAND FROM PAVED AREAS AND REFRESH SAND PITS TO BE LEVEL WITH CURBS.
15. CLEAN AND PREPARE AREA TO RECEIVE OVERLAY SPRAY COAT. INSTALL SPRAY COAT FINISH (COLOR BLACK).
16. ADJUST STORM DRAIN AND CLEANOUT ELEVATION TO UNDERSIDE OF SYNTHETIC SURFACING PER DETAIL 08 ON SHEET TF-05.
17. CLEAN, PRIME, AND PAINT EXISTING STORAGE CONTAINERS, INCLUDING SECURITY BARS. CONTRACTOR TO PUSH CONTAINERS TIGHT WHERE NECESSARY AND PAINT ALL EXPOSED SIDES INCLUDING ROOFS.

SURFACING LEGEND:

- SYNTHETIC TURF PLAYING FIELD
- RUBBERIZED SURFACE OVER EXISTING TRACK
- EXISTING CONCRETE SURFACE
- SYNTHETIC SPRAY MAT SURFACE
- LIMITS OF CONSTRUCTION
- KEYNOTE CALLOUT SYMBOL

GENERAL NOTES:

1. ALL COMPETITION REQUIRED STRIPES AND MARKINGS MUST BE INLAID AND MUST MEET THE LATEST REQUIREMENTS OF NFHS FOOTBALL AND SOCCER RULES. FOOTBALL MARKINGS TO BE WHITE AND SOCCER MARKINGS TO BE YELLOW.
2. GENERAL CONTRACTOR IS RESPONSIBLE FOR PREPARATION OF THE BASE IN THE TURF AREAS AND FOR COORDINATION WITH THE TURF INSTALLER'S WORK. TURF INSTALLER MUST SUBMIT COMPLETE SHOP DRAWINGS AND COLOR SAMPLES FOR REVIEW AND APPROVAL PRIOR TO INSTALLATION OF SYNTHETIC TURF. SUBMITTALS FOR SHOP DRAWINGS AND COLOR SAMPLES MUST BE IN ACCORDANCE WITH THE SPECIFICATIONS.
3. THE OWNER MUST REVIEW AND APPROVE THE FONTS USED FOR YARD LINE NUMBERING, ENDZONE LETTERING, AND TRACK MARKINGS PRIOR TO INSTALLATION OF THE SYNTHETIC TURF OR STRIPING OF THE TRACK.
4. ALL SYNTHETIC SURFACE TRACK MARKINGS MUST BE CALIBRATED, CERTIFIED, AND CONFORM TO THE LATEST REQUIREMENTS OF NFHS.
5. THE EXISTING DRAINAGE SYSTEM MUST BE MAINTAINED OR REPAIRED WHEREVER DAMAGE IS DISCOVERED. ALL DRAINAGE SYSTEMS WITHIN LIMIT OF WORK SHALL BE CLEANED AND FLUSHED BY CONTRACTOR PER SPECIFICATIONS.
6. SUPPLY 2 BAGGED YARDS OF JUMP PIT SAND FOR ATTIC STOCK.

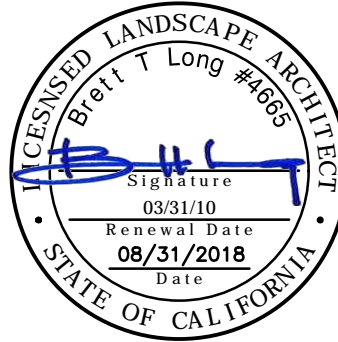

REV.		
1	ADDENDUM 1	8/31/2018
2	ADDENDUM 2	8/31/2018
3	ADDENDUM 3	9/14/2018

ANDREW P. HILL HIGH SCHOOL
TRACK & FIELD RESURFACING
3200 Senter Road
San Jose, CA


SCALE:	1"=30'
DESIGNED:	BTL
DATE:	8/31/2018
DRAWN:	ZTP
PROJ.	18-120
APPROVED:	

SURFACING PLAN


DWG. NO.

TF-03


This plan document set is the sole property of Lloyd Consulting Group, LLC. No alterations to these plans, other than adding "as-built" information, are allowed by anyone other than authorized Lloyd Consulting Group, LLC employees.

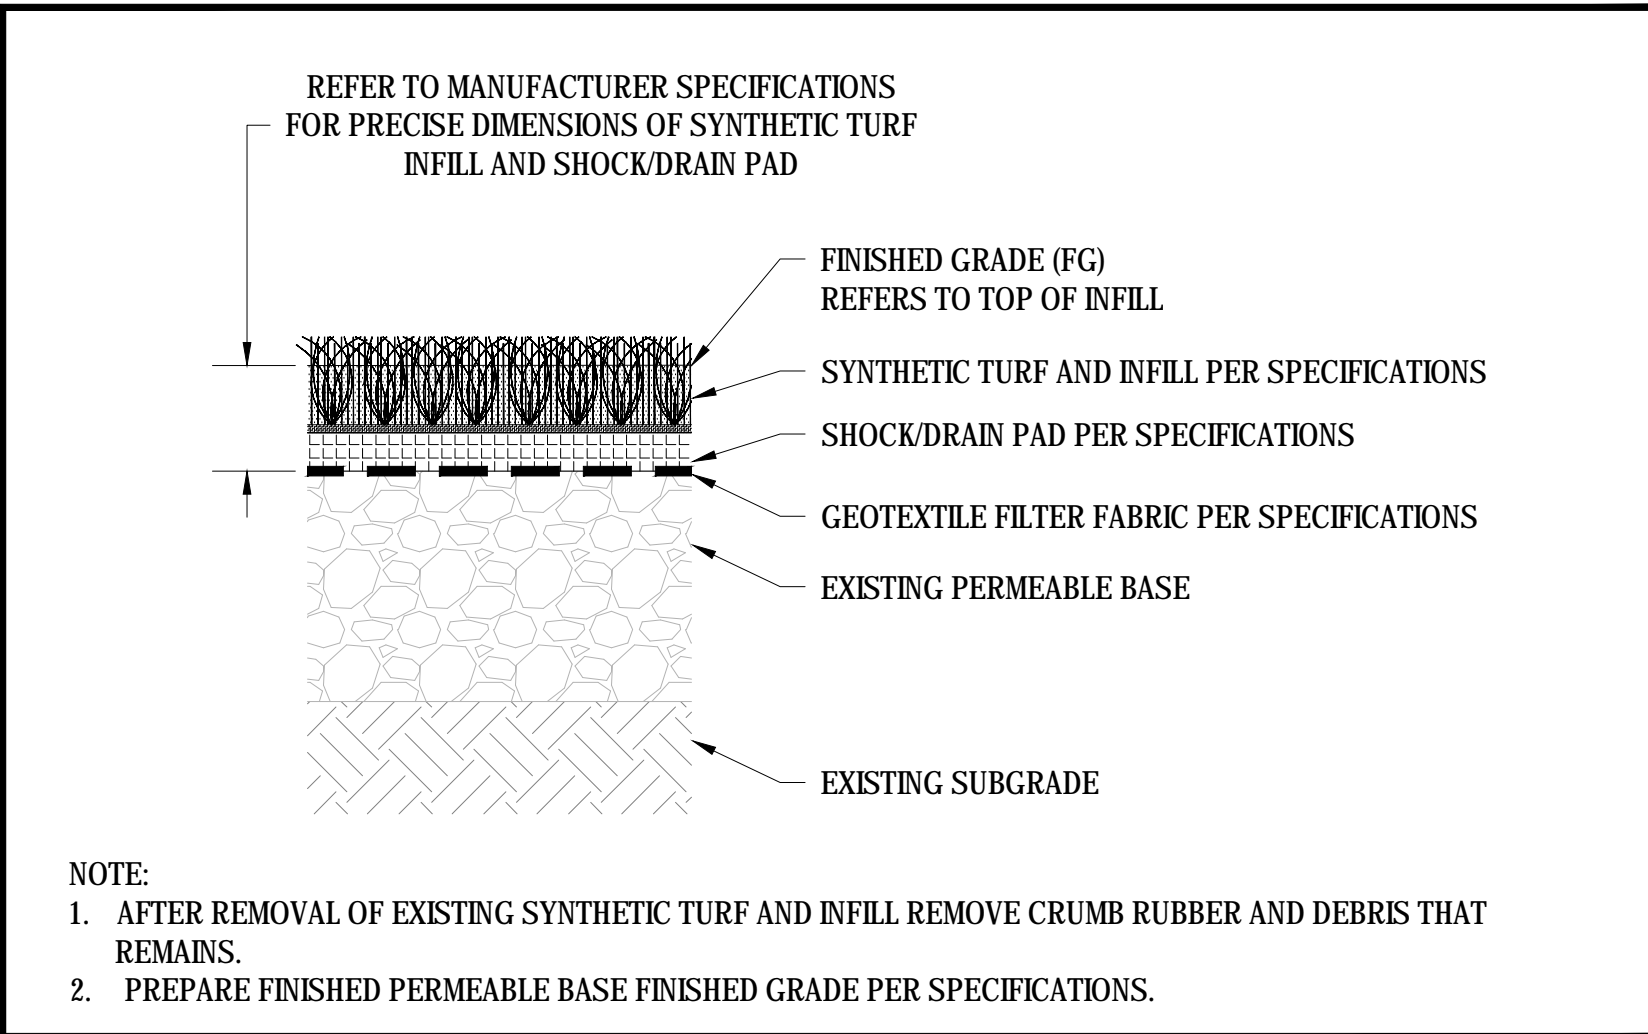


01 SYNTHETIC TURF SURFACING
SCALE: NTS

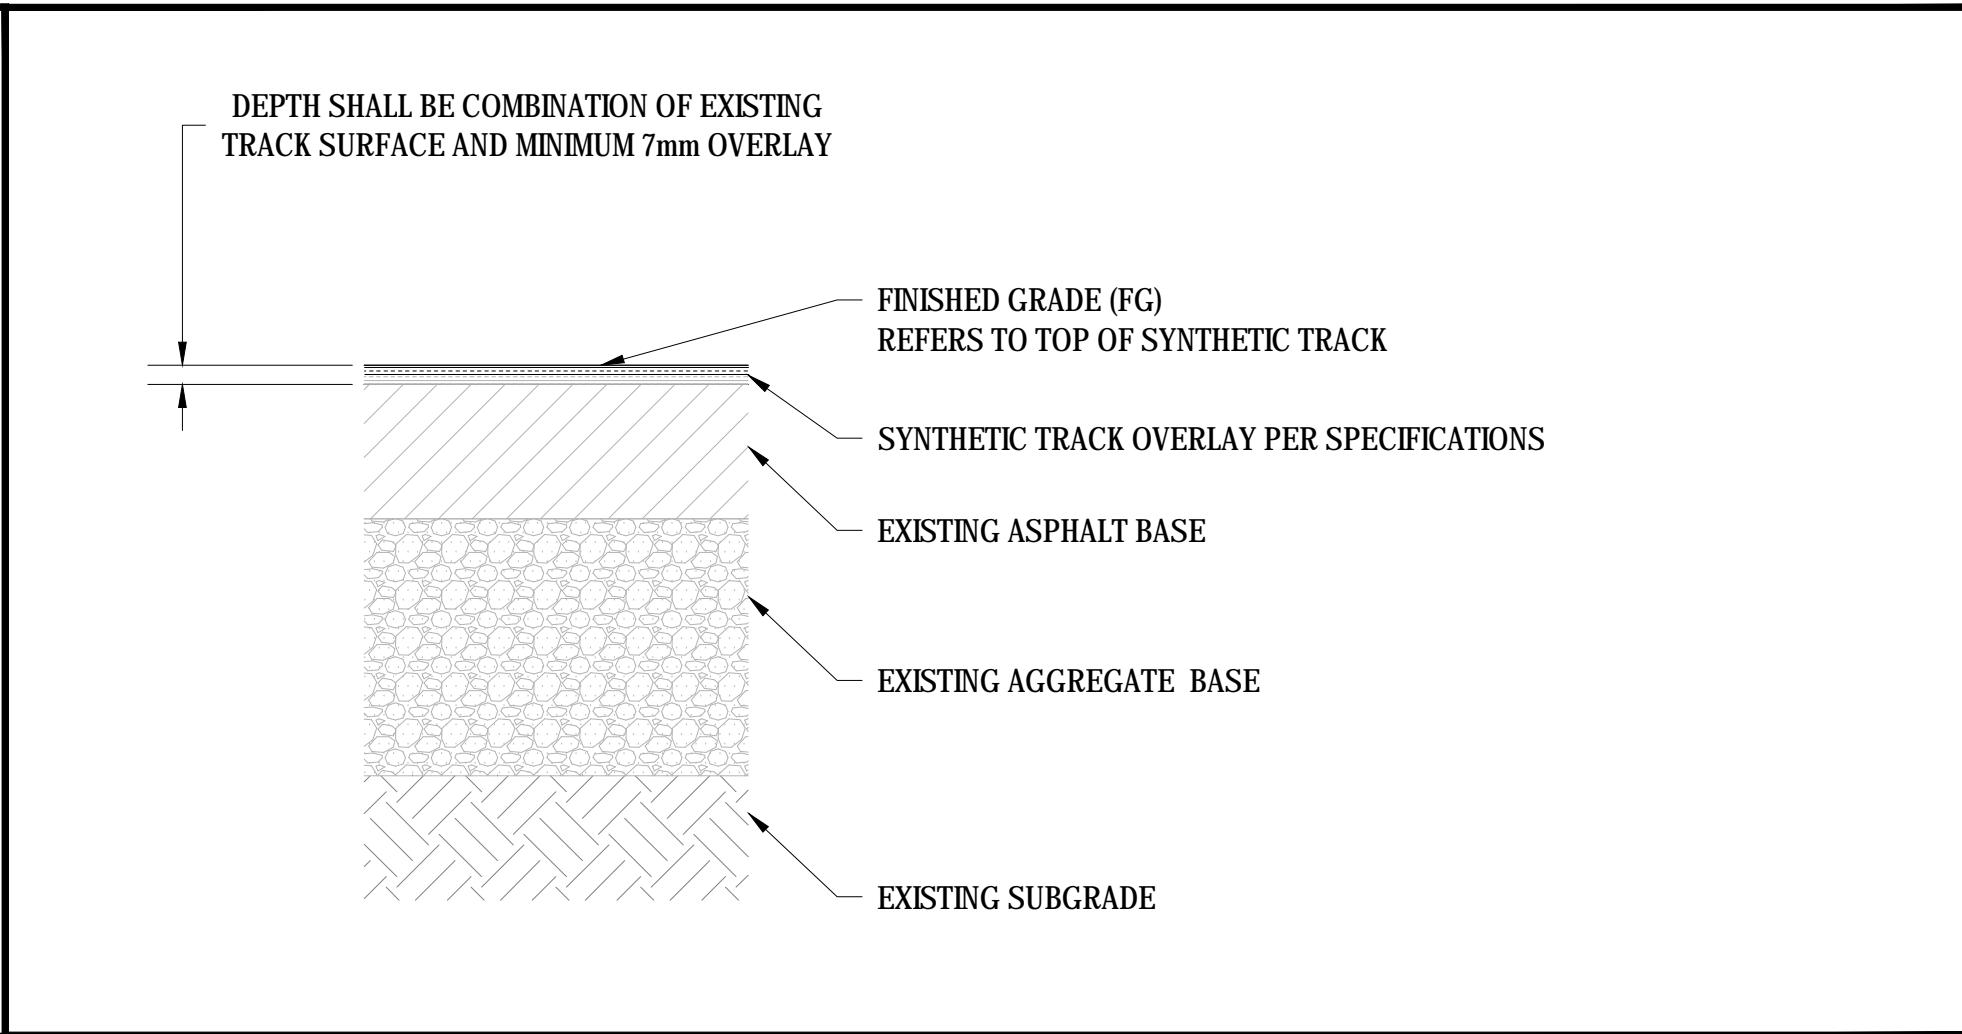


02 SYNTHETIC TRACK SURFACING
SCALE: NTS

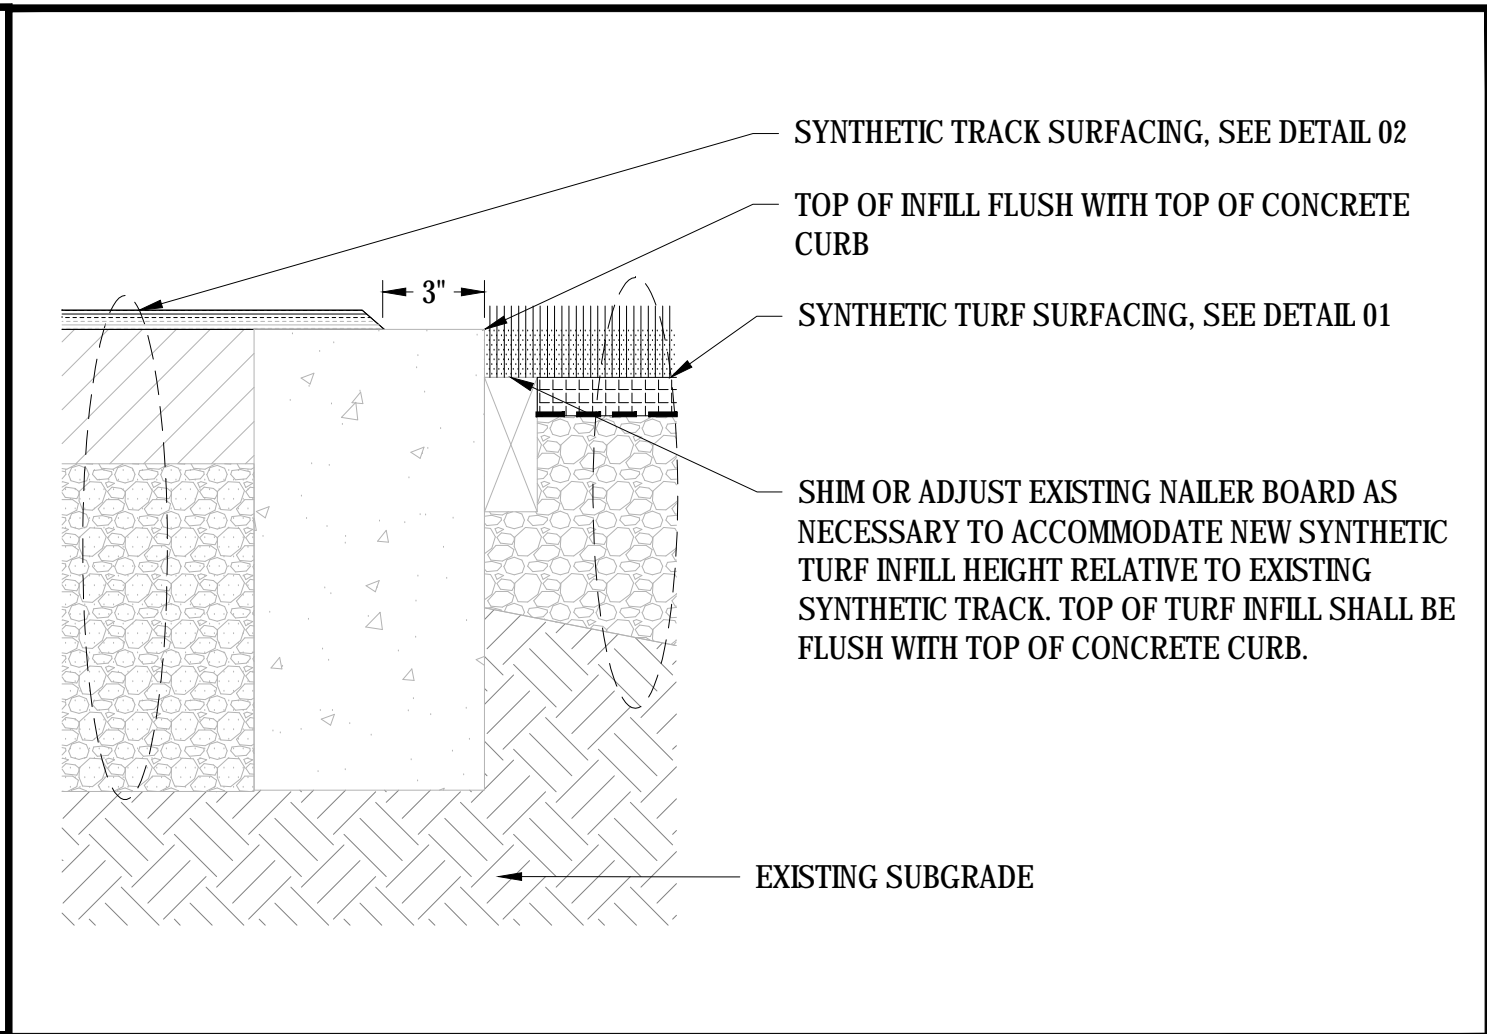


03 SYNTHETIC SURFACING & NAILER AT CURB EDGE
SCALE: NTS

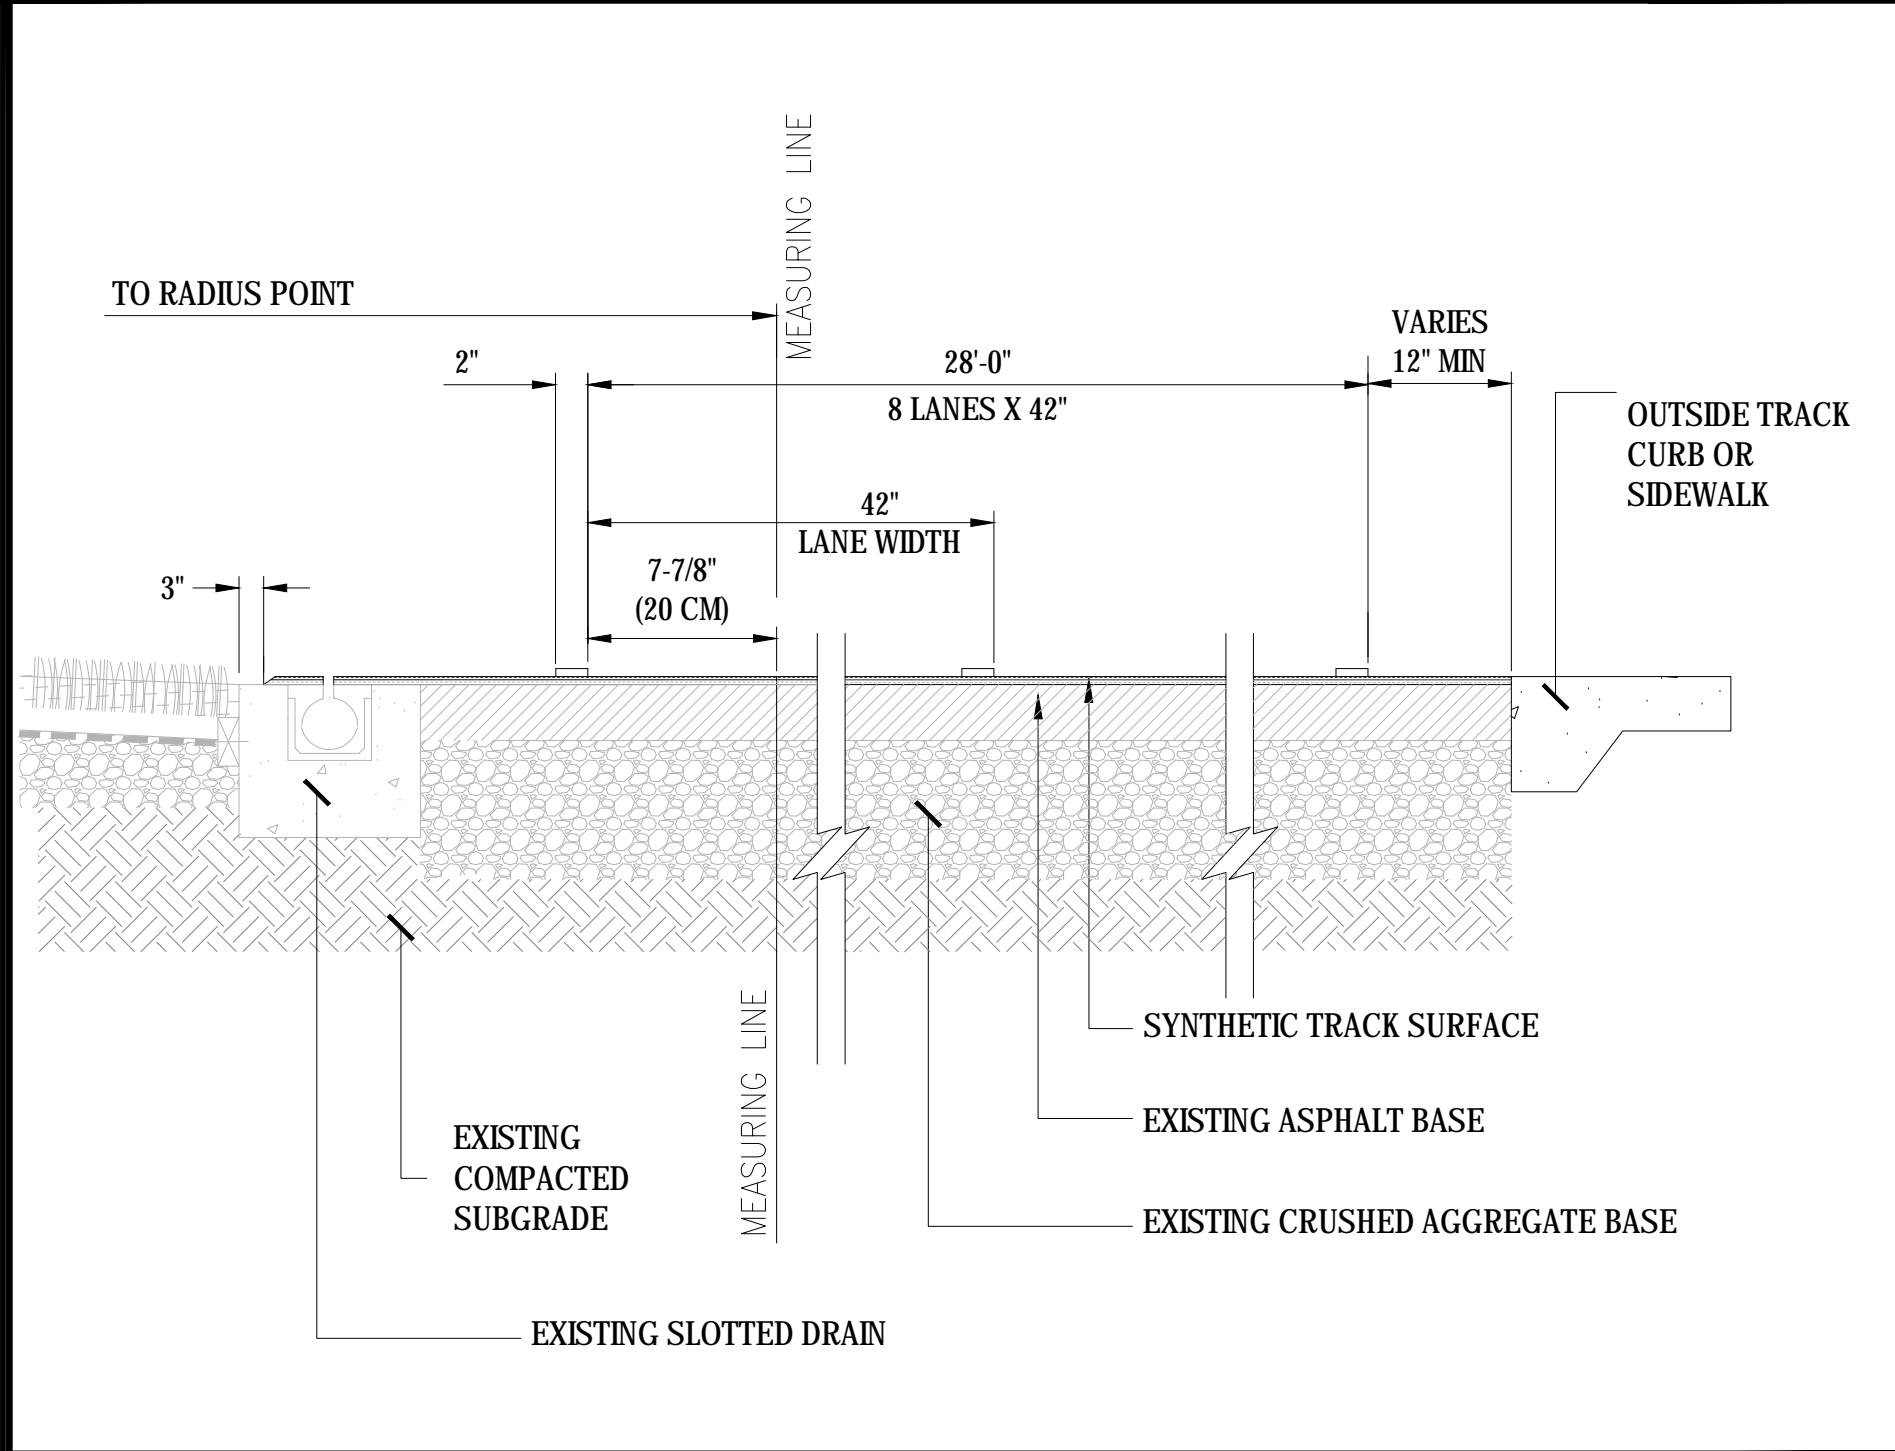


04 RUNNING TRACK LANE DIMENSIONS
SCALE: NTS

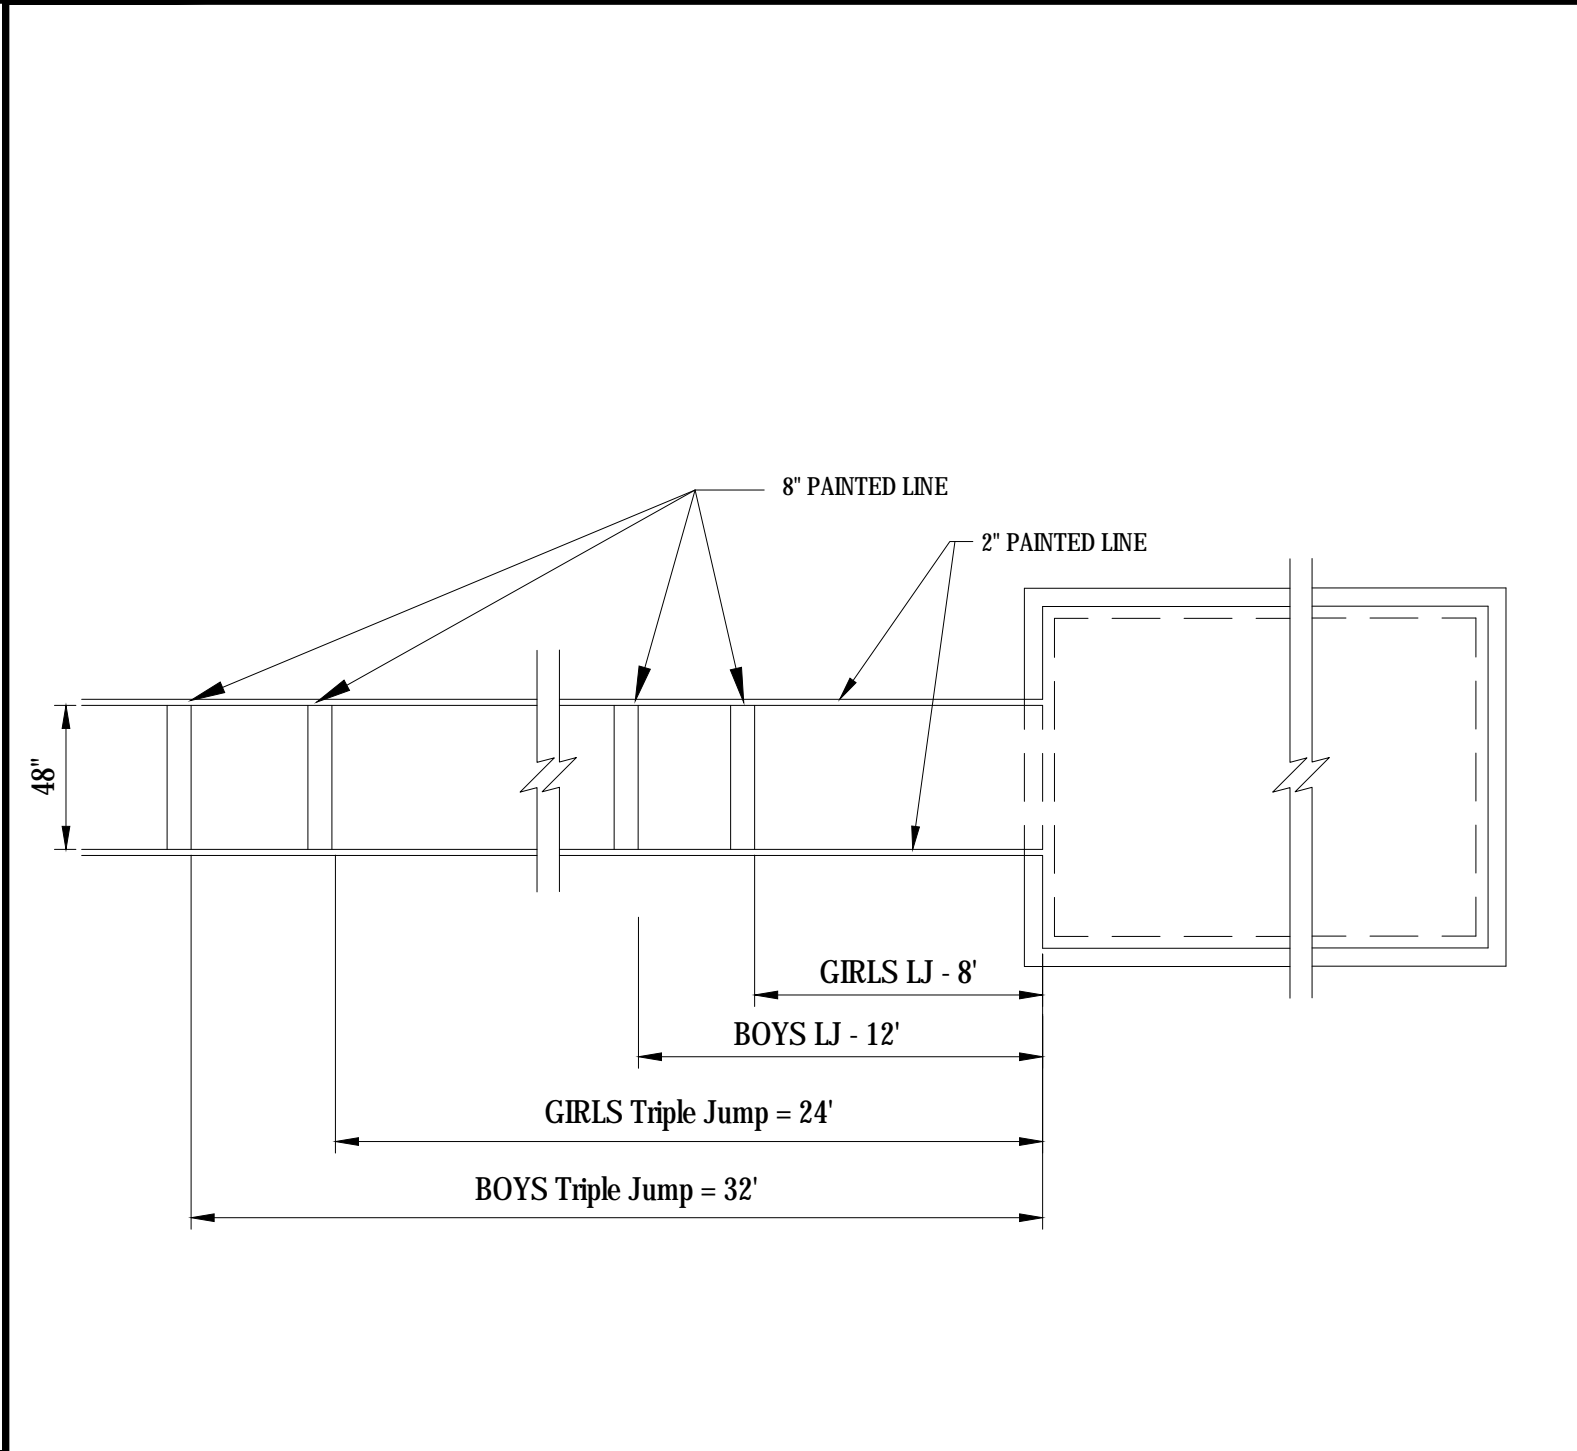


05 LONG/TRIPLE JUMP - PLAN VIEW
SCALE: NTS

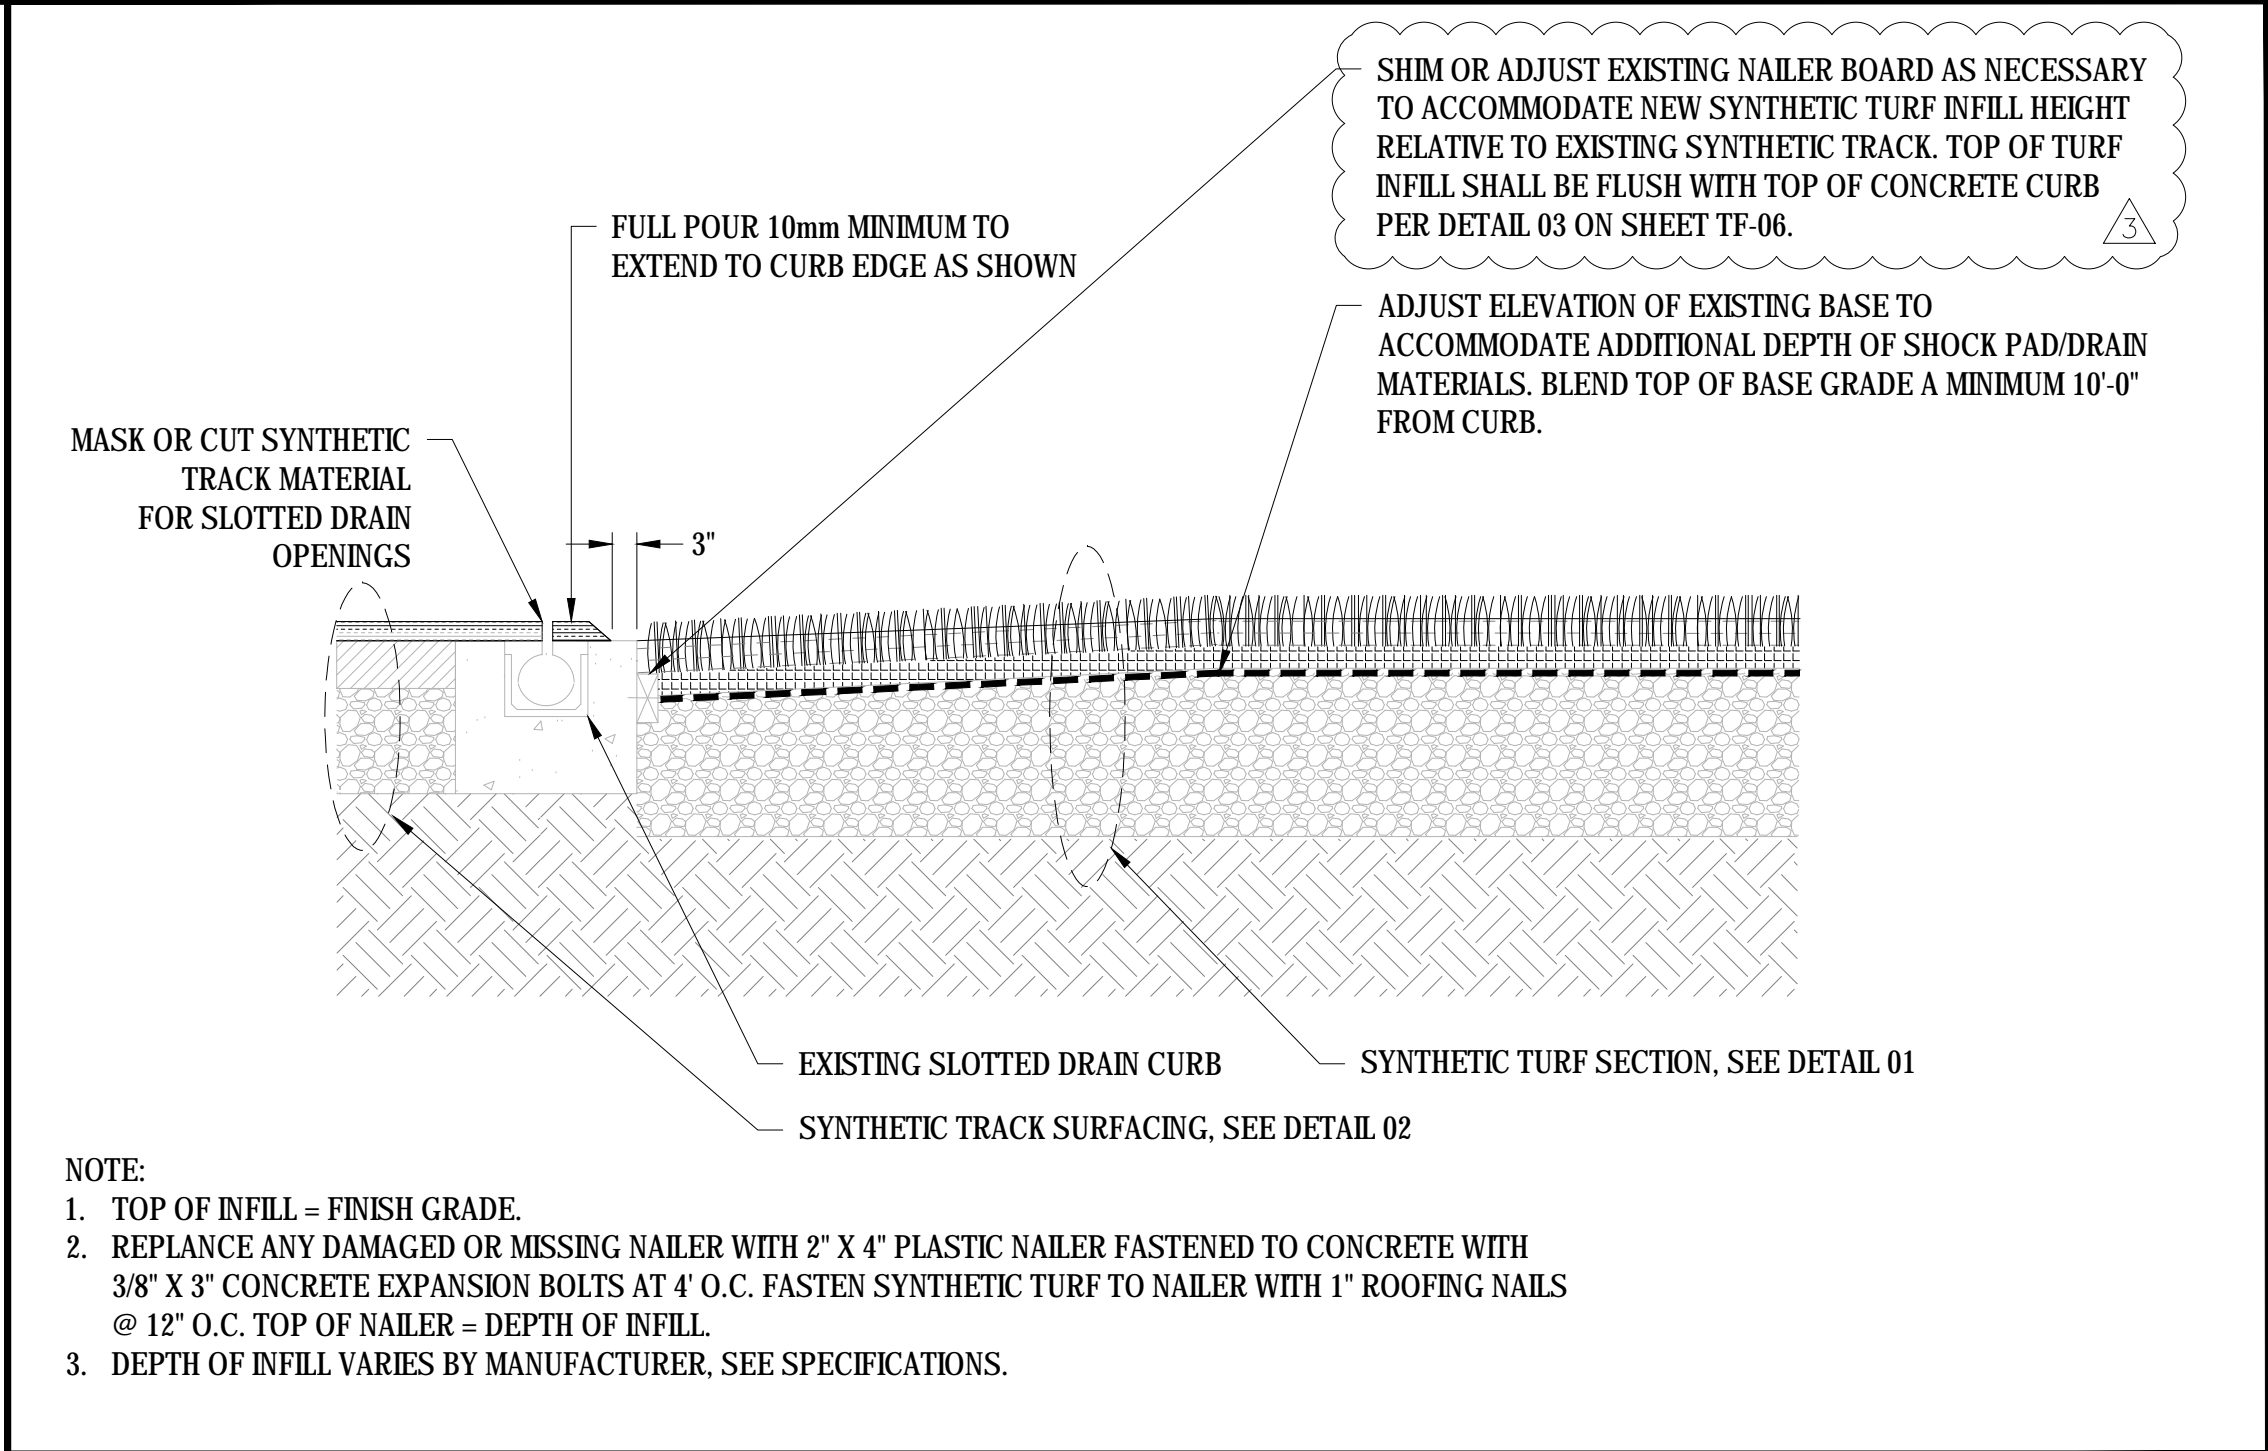


06 SYNTHETIC SURFACING AT SLOTTED DRAIN
SCALE: NTS

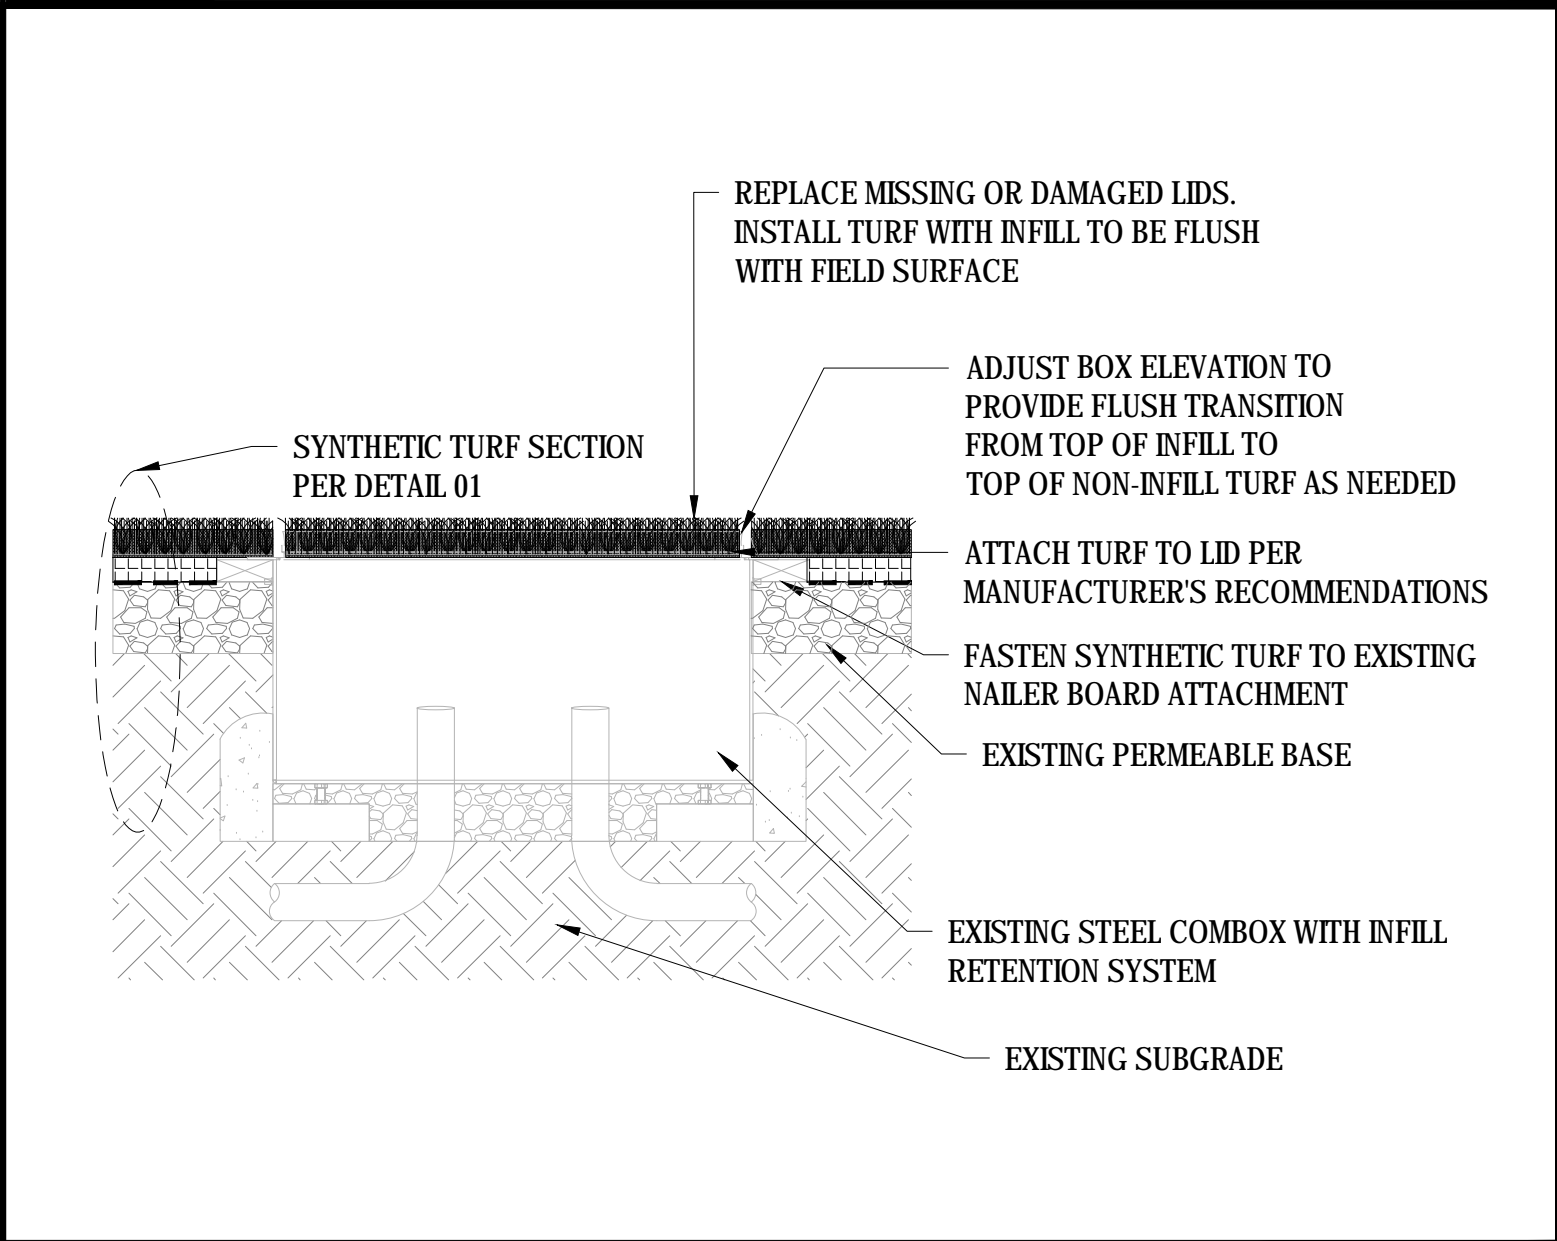

07 EXISTING COMBOX IN SYNTHETIC TURF
SCALE: NTS

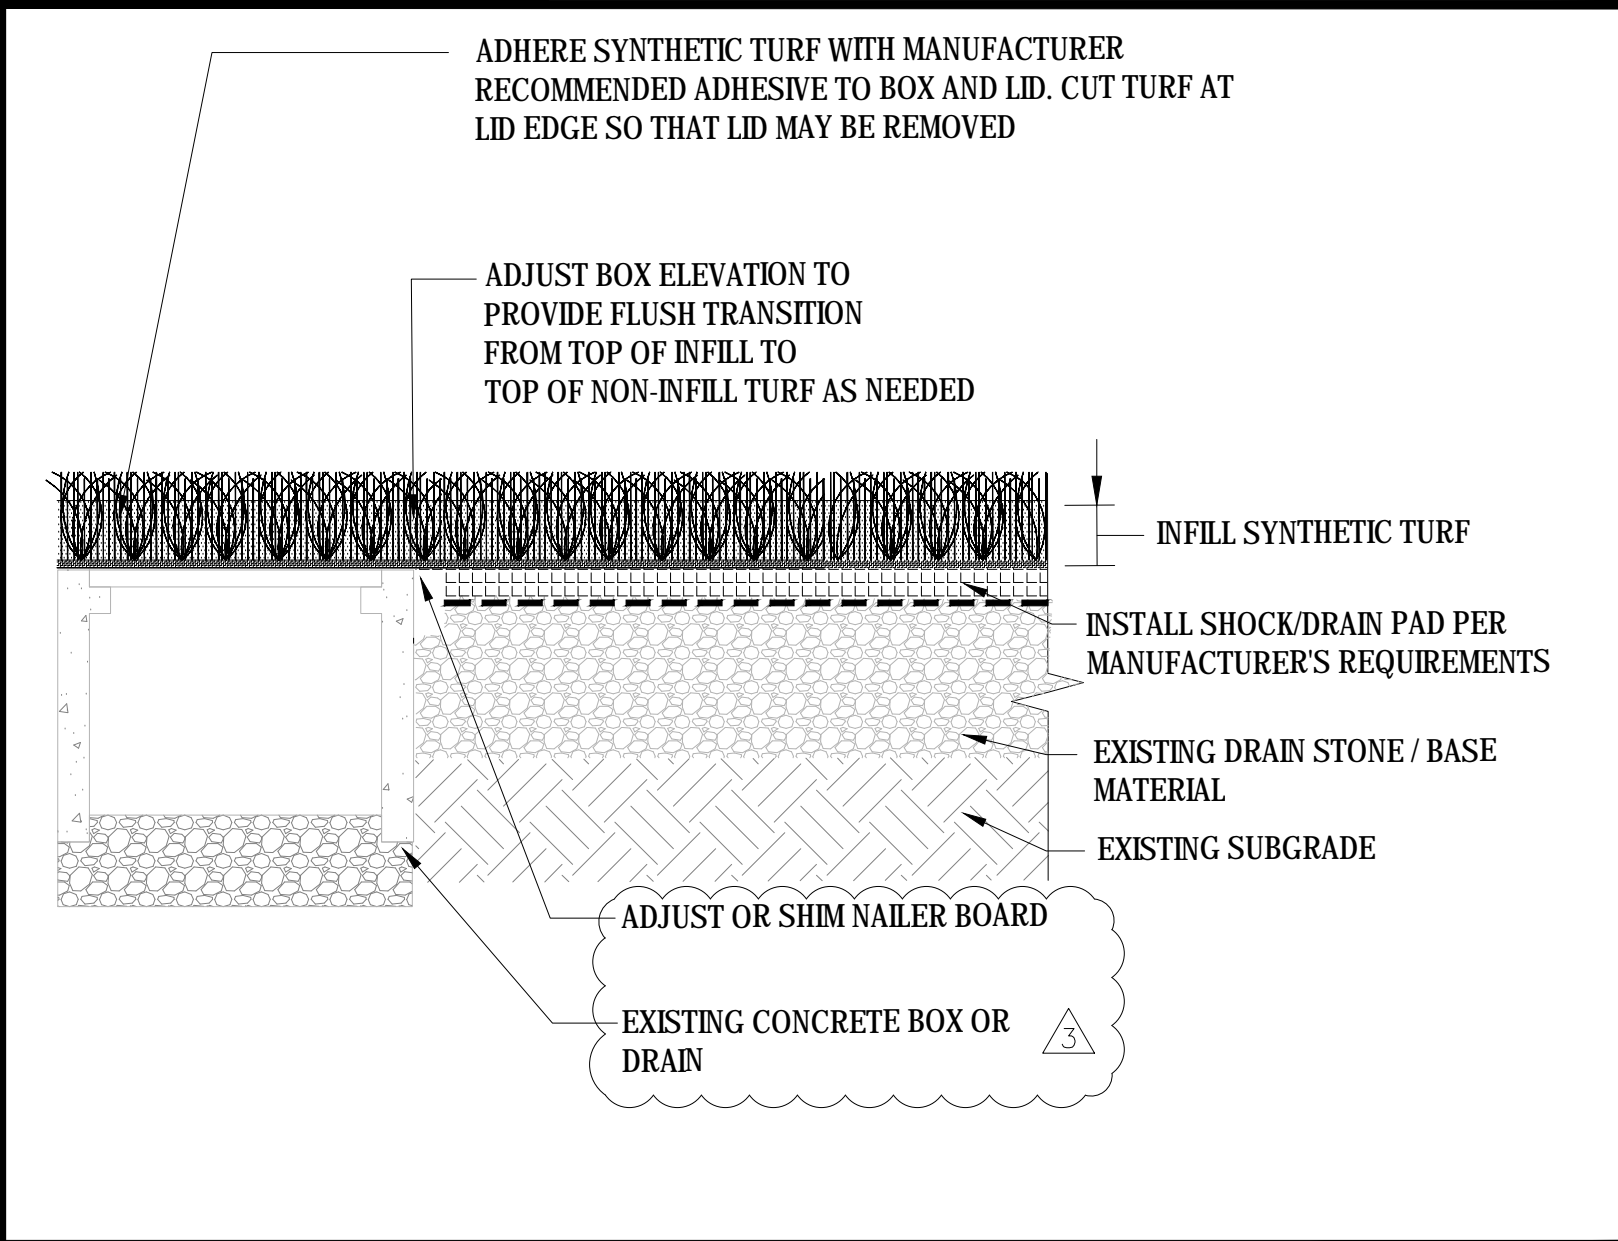

08 EXISTING CONCRETE BOX IN SYNTHETIC TURF
SCALE: NTS

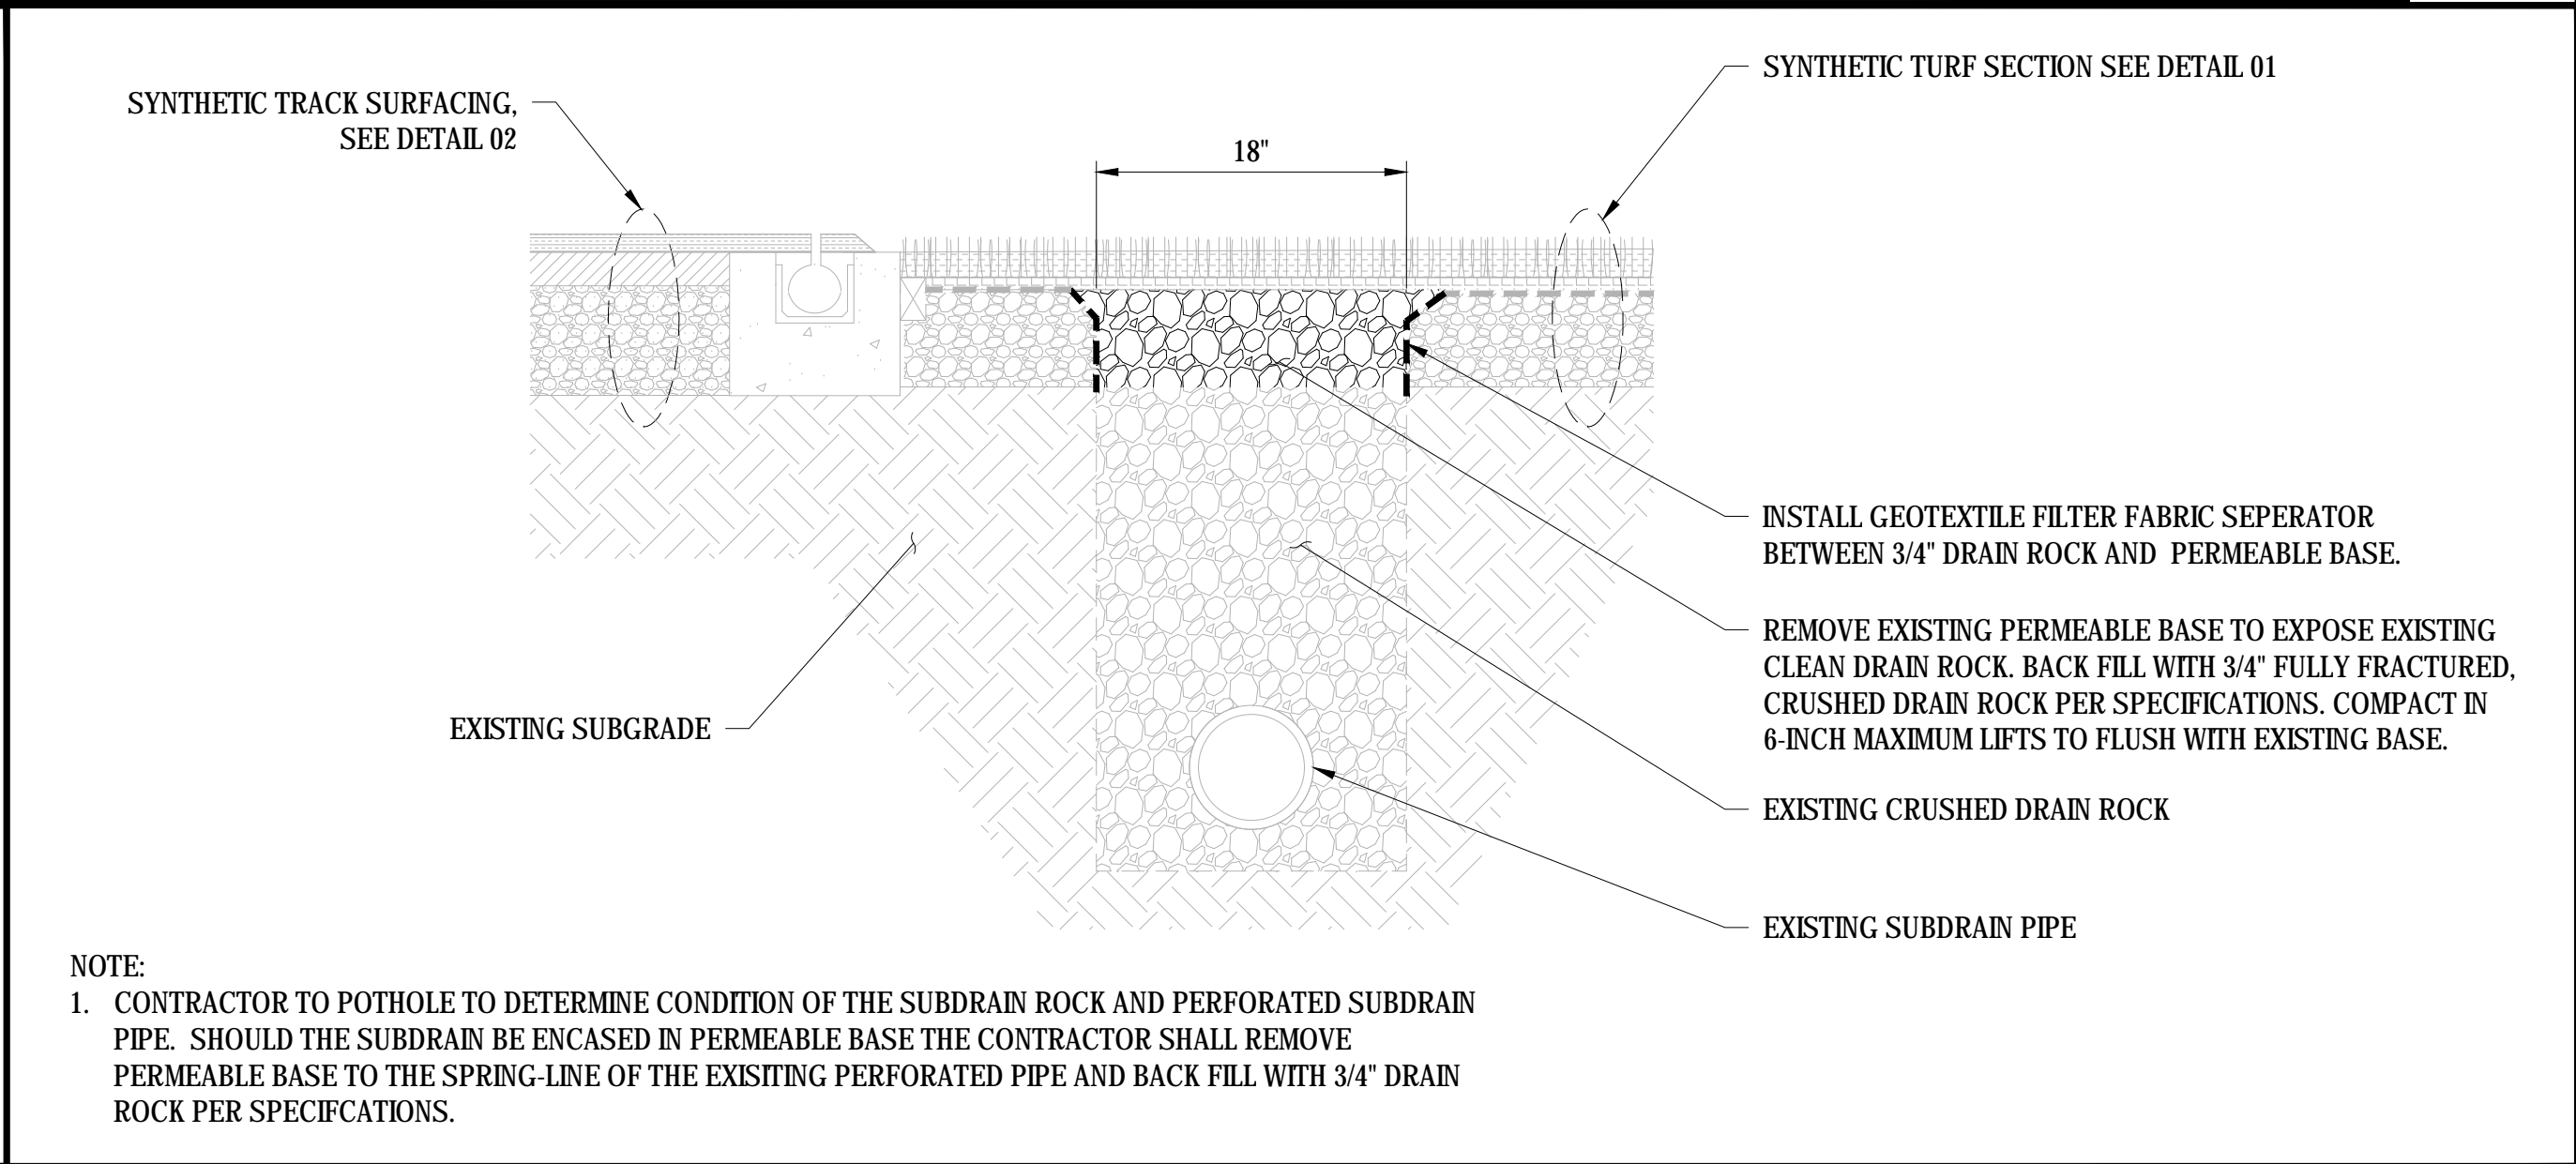

09 SUBDRAIN REPAIR
SCALE: NTS

REV.	
ADDENDA 1	8/31/2018
ADDENDA 2	8/31/2018
ADDENDA 3	9/14/2018

ANDREW P. HILL HIGH SCHOOL
TRACK & FIELD RESURFACING
3200 Senter Road
San Jose, CA




SCALE:	N.T.S.
DESIGNED:	BTL
DATE:	8/31/2018
DRAWN:	-
PROJ.	18-120
APPROVED:	

DETAILS

DWG. NO.

TF-05

This plan document set is the sole property of Lloyd Consulting Group, LLC. No alterations to these plans, other than adding "as-built" information, are allowed by anyone other than authorized Lloyd Consulting Group, LLC employees.

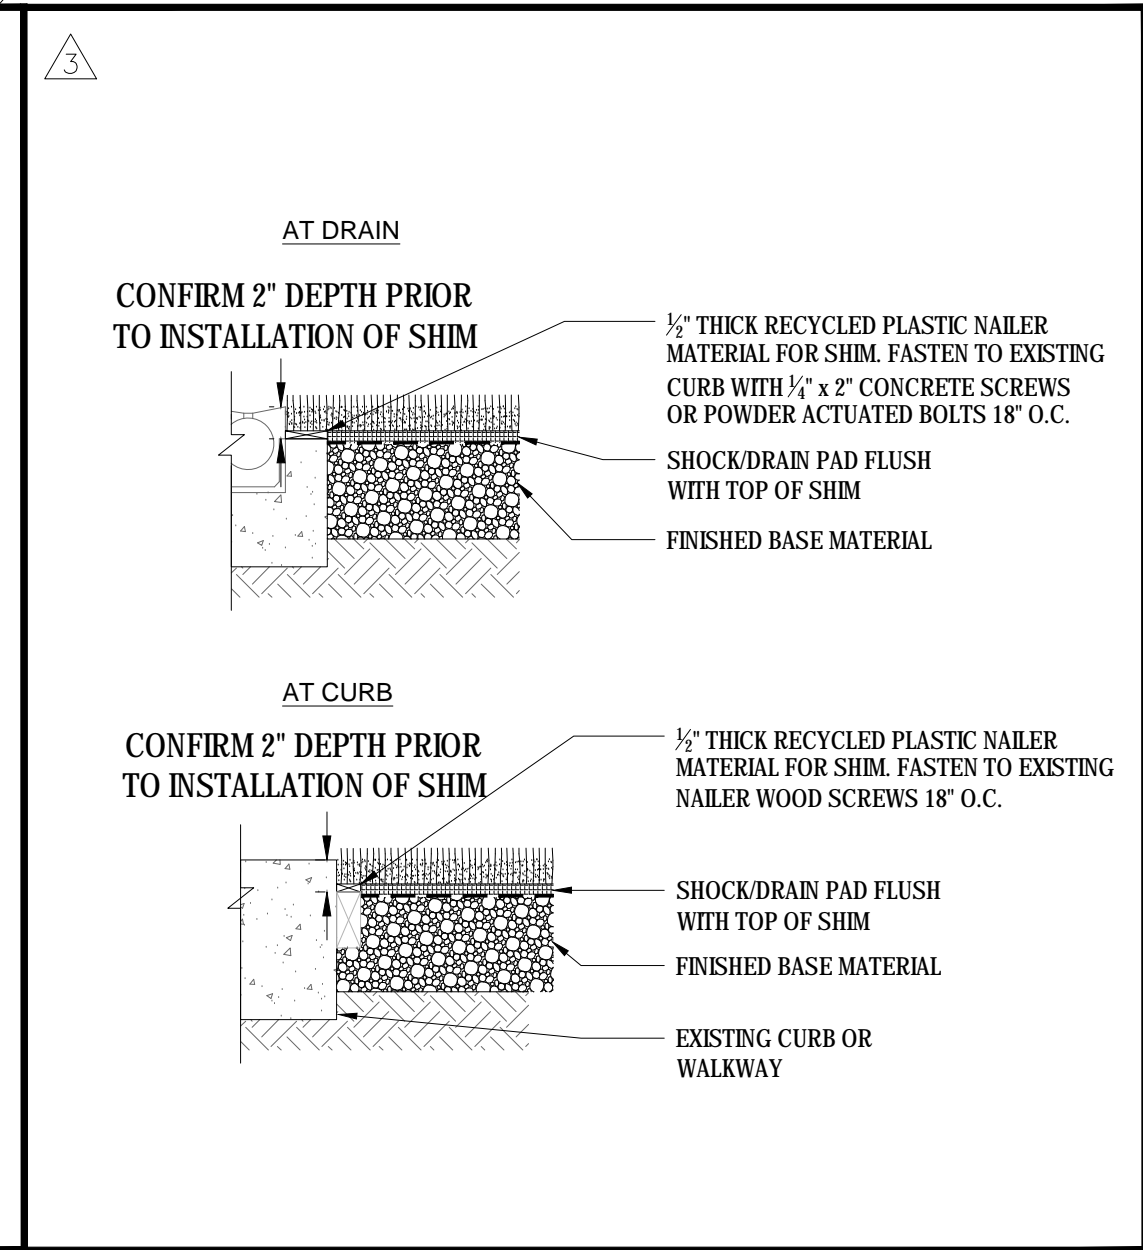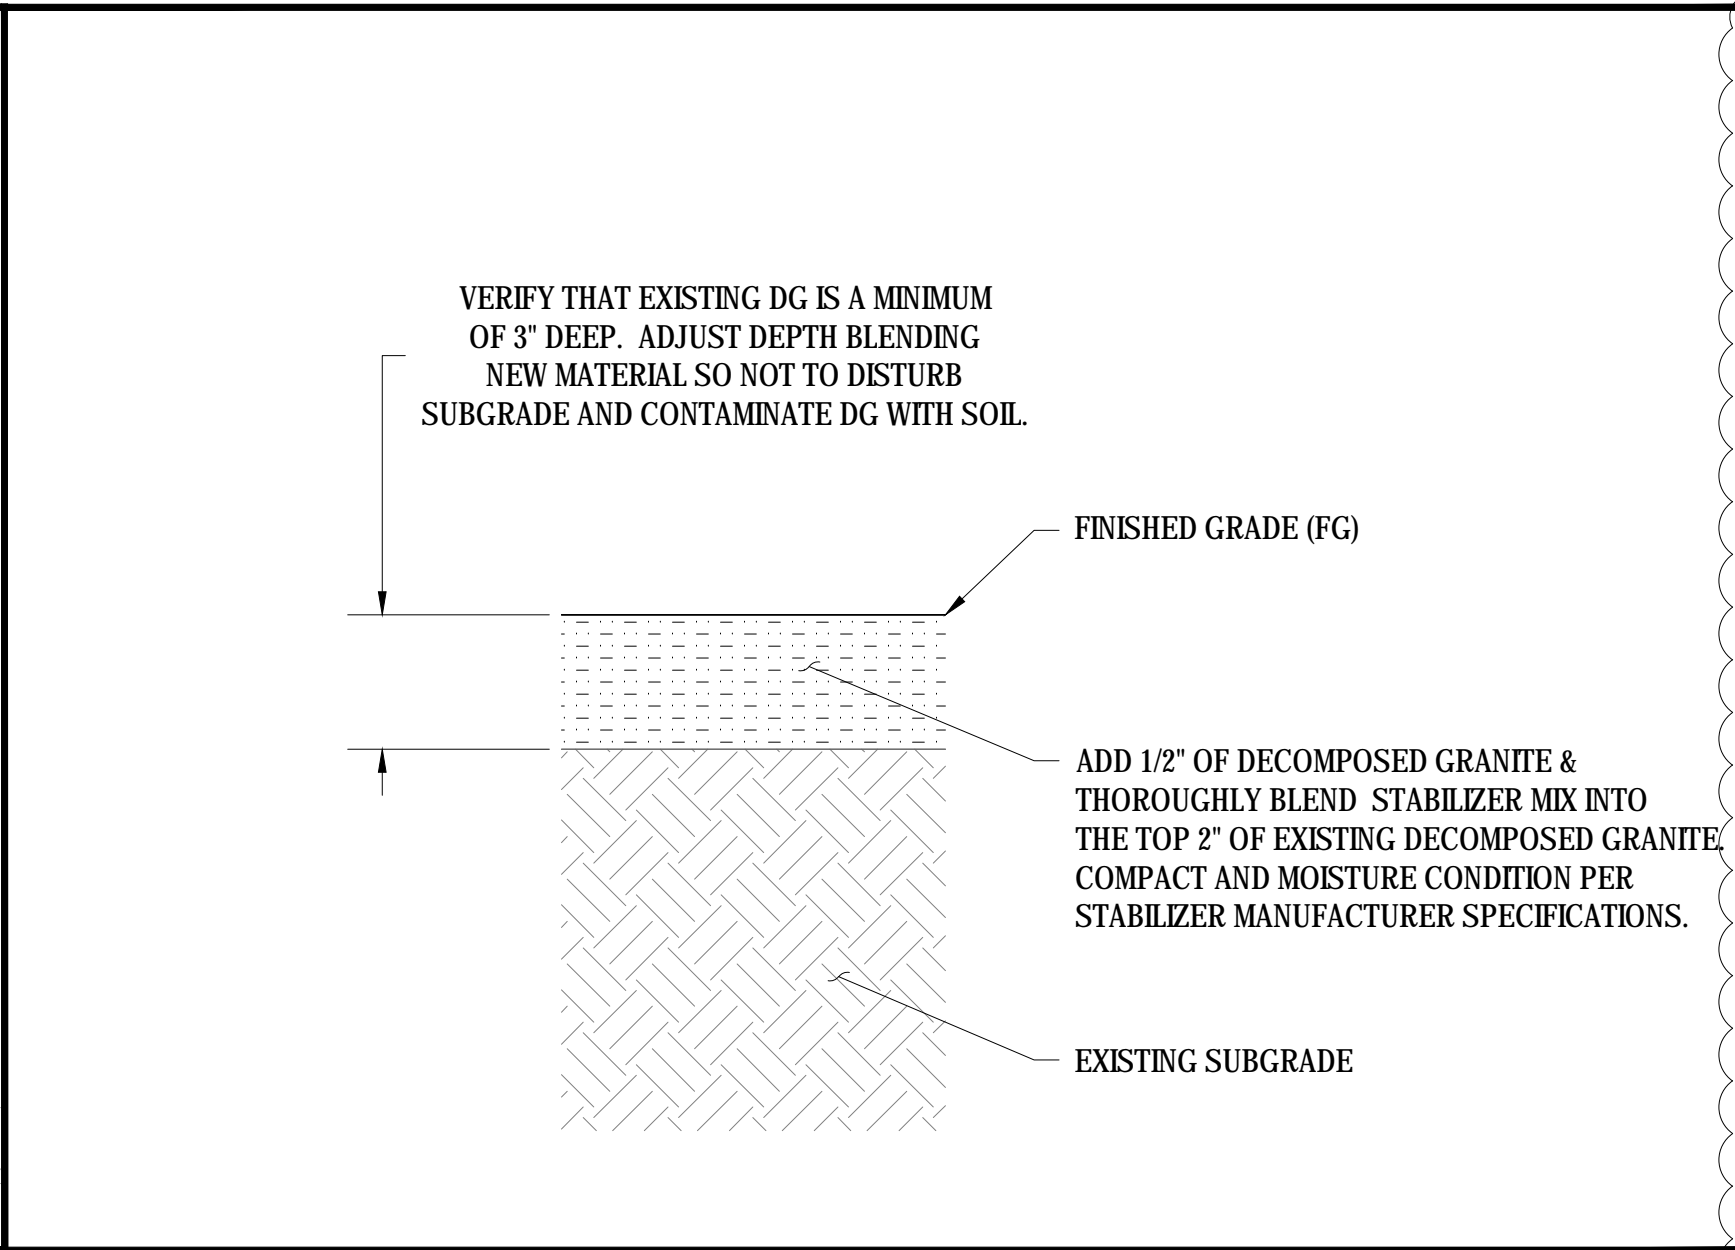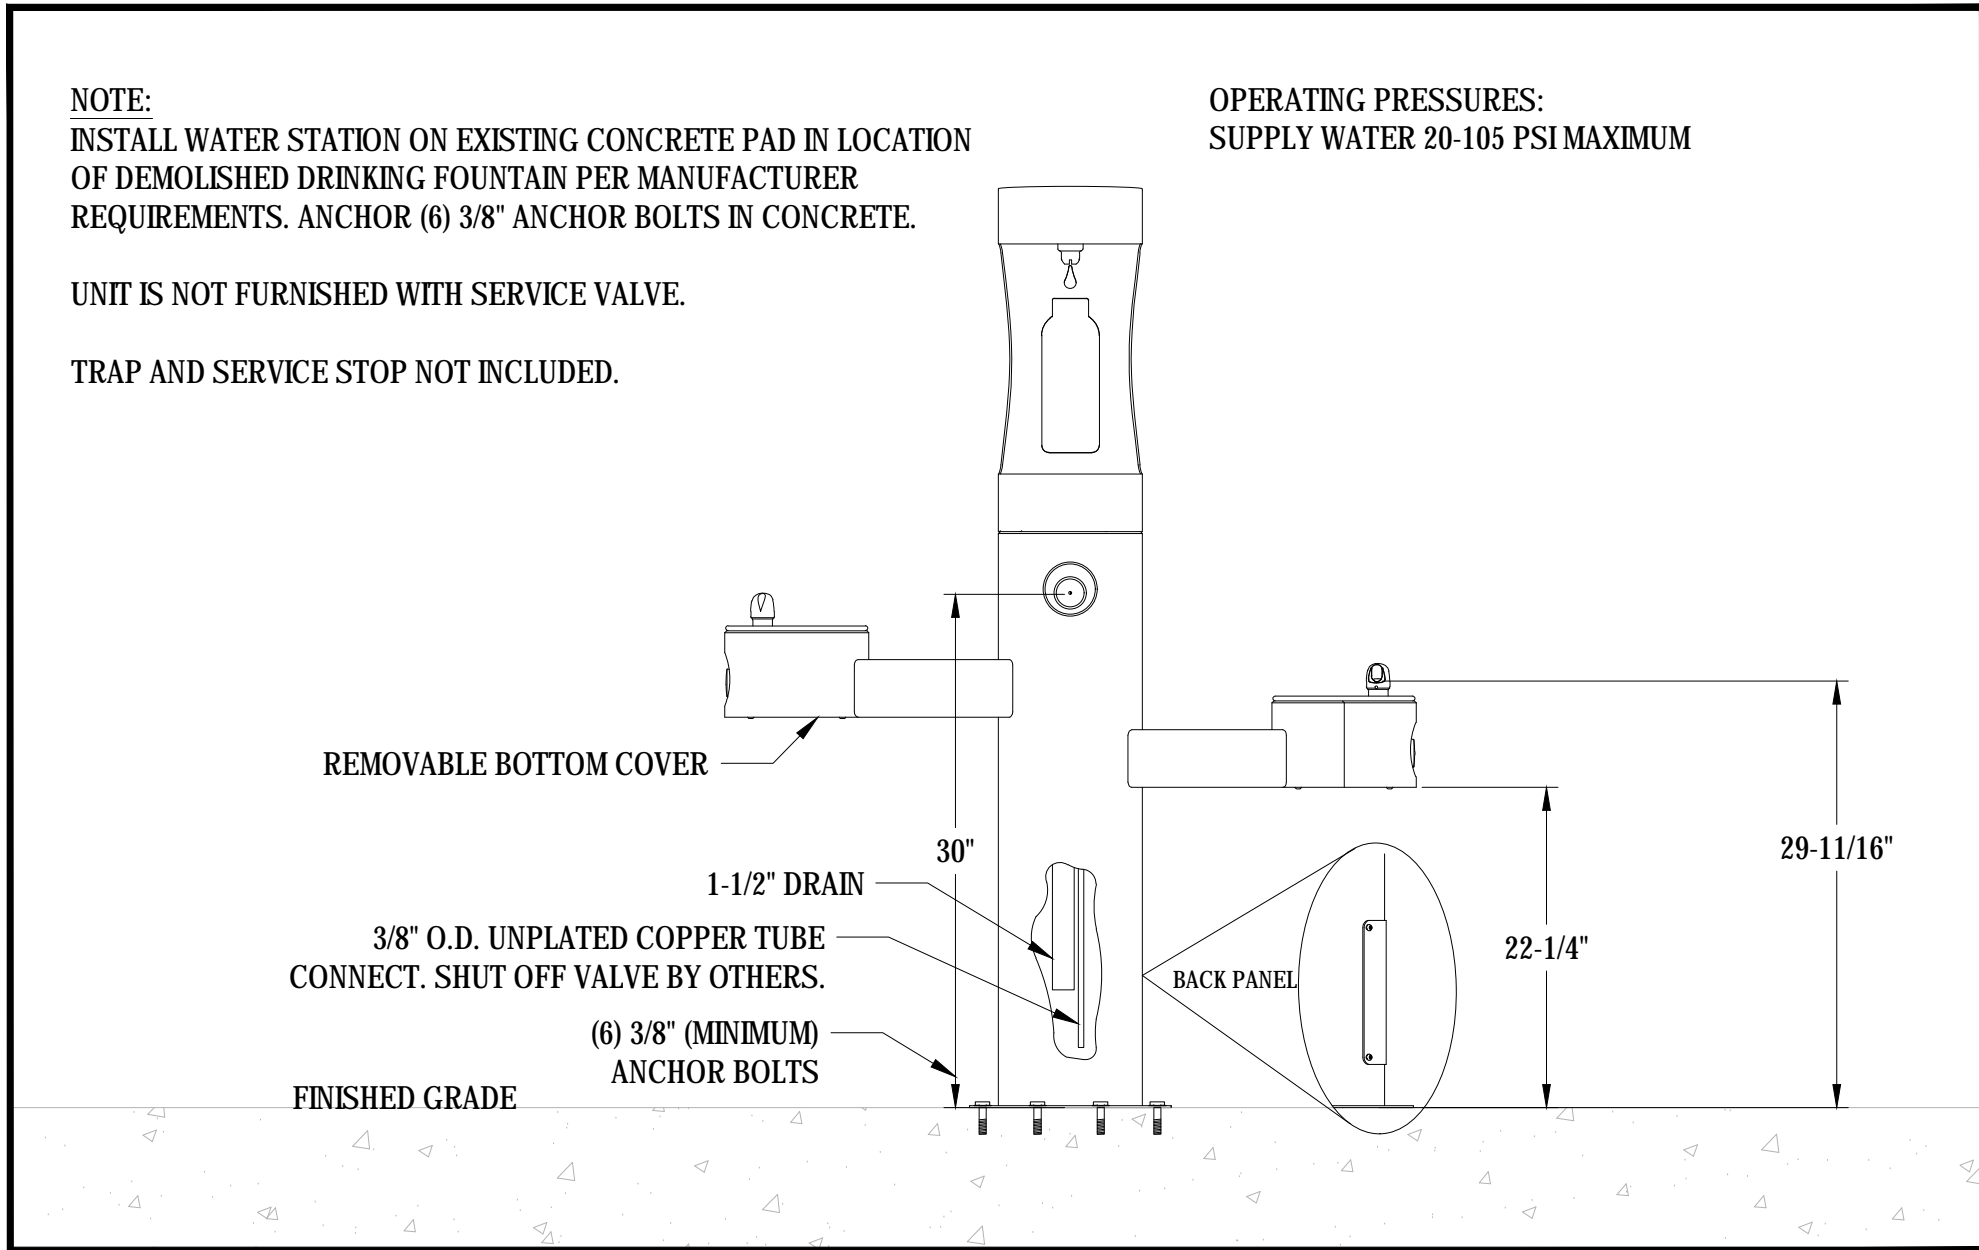

01	DRINKING FOUNTAIN FILLING STATION
	SCALE: NTS

02	DECOMPOSED GRANITE SURFACING
	SCALE: NTS

03	TURF NAILER SHIM
	SCALE: NTS



REV.		
1	ADDENDA 1	8/31/2018
2	ADDENDA 2	8/31/2018
3	ADDENDA 3	9/14/2018

ANDREW P. HILL HIGH SCHOOL
TRACK & FIELD RESURFACING
3200 Senter Road
San Jose, CA

SCALE:	N.T.S.
DESIGNED:	BTL
DATE:	8/31/2018
DRAWN:	—
PROJ.	18-120
APPROVED:	

DETAILS

DWG. NO.

TF-06